

PEARL RIVER
 P 2000
 4-68

MISSISSIPPI
 BOARD OF WATER COMMISSIONERS
 416 North State Street
 Jackson, Mississippi 39201

WATER WELL DRILLERS LOG

4-15 1968 Penion well serv Pearl River
 date well completed firm name county well located

LANDOWNER: Napolen Hayes
 No Box No

description of formations encountered

from to

Rt. 1.

Carriere Miss
 (mailing address)

Red clay	0	27
White sand	27	63
" Clay	63	92
Blue clay	92	146
Grey sand	146	178

WELL LOCATION:

sec. 15 T. 4 S. R. 17 W.
2 miles North of Mill Creek
 (distance) (direction) (nearest town)

WELL PURPOSE: Home
 (home, irrigation, municipal, industrial)

WELL COMPLETION DATA:

- (1) diameter (inches) 2"
- (2) total depth (feet) 178
- (3) static water level (feet) 78 below top of ground.
- (4) casing Caso. Steel 173
 (material) (depth)

2" if telescope see back.
 (size)

- (5) screen 5' 173
 (length) (depth to top)

015 2" S. Steel
 (size) (material)

- (6) pump 1/2 3 1/2
 (HP) (yield gpm)


Elec
 (type power)

- (7) electric log NO
 (yes or no)

(organization running log)

- (8) how well bottom plugged BW Value

DRILLERS REMARKS:

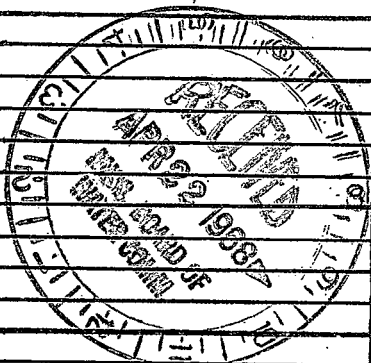

If well telescopes please sketch and show depths.

GROUND LEVEL

		X	

SECTION 15

Please indicate well location X.

ADDITIONAL INFORMATION

If more than one screen,
show locations of each on sketch.