

Pearl River  
P 2007  
6-68

MISSISSIPPI  
BOARD OF WATER COMMISSIONERS  
416 North State Street  
Jackson, Mississippi 39201

WATER WELL DRILLERS LOG

June 16 1968 Les Ludwig Pearl River  
date well completed firm name county well located


LANDOWNER: Les Ludwig  
Poplarville Miss  
(mailing address)

description of formations encountered	from to	
	feet	feet
Surface	0	1
Clay	1	5
Sand & gravel	5	47

WELL LOCATION:  
sec 39 T N R E  
18 miles NW of Poplarville  
(distance) (direction) (nearest town)

WELL PURPOSE: Domestic  
(home, irrigation, municipal, industrial)


- WELL COMPLETION DATA:
- (1) diameter (inches) 2
  - (2) total depth (feet) 47
  - (3) static water level (feet) 8 below top of ground.
  - (4) casing Galv 42  
(material) (depth)  
1 1/2 if telescope see back.  
(size)
  - (5) screen 5' 42  
(length) (depth to top)  
2" (size) (material)
  - (6) pump 1 15  
(HP) (yield gpm)  
Electric  
(type power)
  - (7) electric log NO  
(yes or no)
  - (organization running log)
  - (8) how well bottom plugged OK

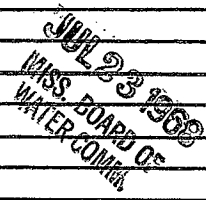

DRILLERS REMARKS:

If well telescopes please sketch and show depths.

GROUND LEVEL

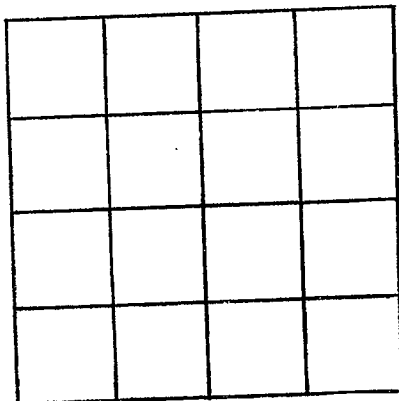

SECTION \_\_\_\_\_

Please indicate well location X.

ADDITIONAL INFORMATION

If more than one screen,  
show locations of each on sketch.