

Pearl River  
P 2008  
8-23-68

MISSISSIPPI  
 BOARD OF WATER COMMISSIONERS  
 416 North State Street  
 Jackson, Mississippi 39201

WATER WELL DRILLERS LOG

8-23 1968 Periton Well Serv Pearl River  
 date well completed firm name county well located

LANDOWNER: Lawson Taylor

description of formations encountered	From	To
Surface Clay	0	18
Red Sand	18	22
White Clay	22	28
Blue Clay	28	212
Grey Sand	212	248

Carriere Miss.  
 (mailing address)

WELL LOCATION:  
 sec. 33 T. 4 S. R. 17 W.  
5 miles West of McNeill  
 (distance) (direction) (nearest town)

WELL PURPOSE: Home  
 (home, irrigation, municipal, industrial)


WELL COMPLETION DATA: 4 1/2 Drilled

- (1) diameter (inches) 2"
- (2) total depth (feet) 238
- (3) static water level (feet) 78 below top of ground.
- (4) casing Galv 233  
 (material) (depth)  
2" If telescope see back.  
 (size)
- (5) screen 5 233  
 (length) (depth to top)  
2" S. Steel  
 (size) (material)
- (6) pump 1 5  
 (HP) (yield gpm)  
Elec  
 (type power)
- (7) electric log NO  
 (yes or no)

(organization running log)

(8) how well bottom plugged Bw Valve


DRILLERS REMARKS:

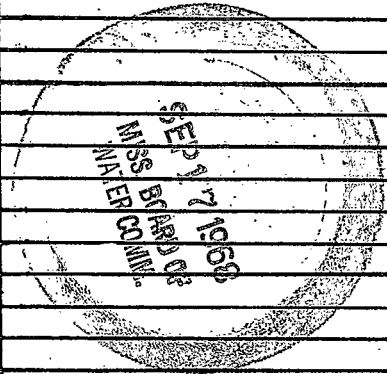

012

If well telescopes please sketch and show depths.

GROUND LEVEL

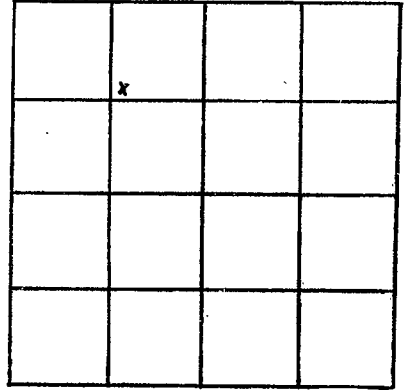

SECTION 33

Please indicate well location X.

ADDITIONAL INFORMATION

If more than one screen,  
show locations of each on sketch.