

PEARL RIVER
P 2008
10-27-75

MISSISSIPPI
 BOARD OF WATER COMMISSIONERS
 416 North State Street
 Jackson, Mississippi 39201

13Y

WATER WELL DRILLERS LOG

10/27 1975 Budgentonson Pearl River
 date well completed firm name county well located

LANDOWNER: Wesley Smith

description of formations encountered

from

to

R T 3 Carriere Miss Red shale 0 22
Red sand 22 60

(mailing address)

WELL LOCATION:

sec. 31 T 4 N R. 19 E
 S W
3 1/2 miles NW of Carriere
 (distance) (direction) (nearest town)

WELL PURPOSE: home
 (home, irrigation, municipal, industrial)


WELL COMPLETION DATA:

- (1) diameter (inches) 4"
- (2) total depth (feet) 60
- (3) static water level (feet) 32 below above top of ground.
- (4) casing PVC 60
 (material) (depth)
4" if telescope see back.
 (size)
- (5) screen 4 x 10 50
 (length) (depth to top)
4" PVC
 (size) (material)
- (6) pump 1/2 600-11gpm
 (HP) (yield gpm)
ELC
 (type power)
- (7) electric log no
 (yes or no)

(organization running log)

(8) how well bottom plugged Sand stuck


DRILLERS REMARKS:

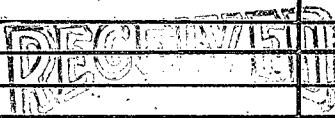

APR 12 1976

If well telescopes please sketch and show depths.

GROUND LEVEL

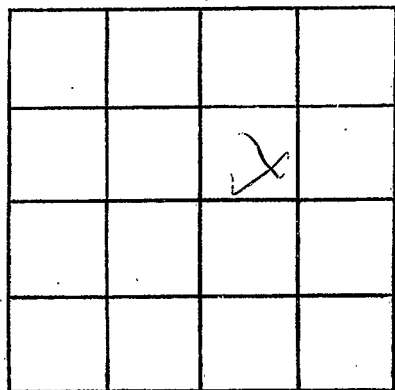

SECTION _____

Please indicate well location X.

ADDITIONAL INFORMATION

If more than one screen,
show locations of each on sketch.