

**PEARL RIVER**  
**P 2000**  
**2-20-76**

**MISSISSIPPI**  
**BOARD OF WATER COMMISSIONERS**  
 416 North State Street  
 Jackson, Mississippi 39201

**WATER WELL DRILLERS LOG**

2/50 19 The Budgeron & Son Pearl River  
 date well completed firm name county well located

**LANDOWNER:** David Forrest  
Box 1  
Carriere Miss.  
 (mailing address)


**WELL LOCATION:**  
 sec. 28 T. 4 N. R. 17 E.  
5 miles north of Carriere  
 (distance) (direction) (nearest town)

**WELL PURPOSE:** home  
 (home, irrigation, municipal, industrial)

**WELL COMPLETION DATA:**

- (1) diameter (inches) 4 X 2
- (2) total depth (feet) 570
- (3) static water level (feet) 64 below top of ground.
- (4) casing Steel, 570  
 (material) (depth)  
4 X 2 if telescope see back.  
 (size)
- (5) screen 10, 570  
 (length) (depth to top)  
12, 12 Steel  
 (size) (material)
- (6) pump 1 1/2 1650 25 gpm  
 (HP) (yield gpm)  
Elect  
 (type power)
- (7) electric log no  
 (yes or no)
- (organization running log)
- (8) how well bottom plugged Sand sharp

description of formations encountered	from	to
Red shale	0	30
white sand	30	70
blue shale	90	185
blue sand	185	215
blue shale	215	290
blue sand	290	355
blue shale	355	410
gray sand	410	450
blue shale	450	501
gray sand	501	570

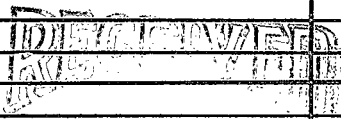

APR 12 1976

DRILLERS REMARKS:

