

Pearl River
P 2011
3/23/77

MISSISSIPPI
 BOARD OF WATER COMMISSIONERS
 416 North State Street
 131 Jackson, Mississippi 39201

WATER WELL DRILLERS LOG

3-23 1977 Bud Pente Pearl River
 date well completed firm name county well located

LANDOWNER:
Wayne Mitchell
Rt. 1, Carriere, Miss.
 (mailing address)

description of formations encountered	from	to
<u>Red shale</u>	<u>0</u>	<u>25</u>
<u>Red sand</u>	<u>22</u>	<u>27</u>
<u>Grey shale</u>	<u>27</u>	<u>120</u>
<u>Red sand</u>	<u>120</u>	<u>140</u>

WELL LOCATION:
 sec. 19 T. 4 N R. 15 E
6 miles W of McNitt
 (distance) (direction) (nearest town)

WELL PURPOSE: Home
 (home, irrigation, municipal, industrial)

WELL COMPLETION DATA:
 (1) diameter (inches) 4 in
 (2) total depth (feet) 140
 (3) static water level (feet) 54 below above top of ground.
 (4) casing PVC 130
 (material) (depth)
 (size) If telescope see back.
 (5) screen 10 130
 (length) (depth to top)
4 PVC
 (size) (material)
 (6) pump 1/2
 (HP) (yield gpm)
electric
 (type power)
 (7) electric log NO
 (yes or no)
 (organization running log)


(8) how well bottom plugged
Sand Shark

DRILLERS REMARKS: No pump furnished

RECEIVED
 SEP 13 1977

If well telescopes please sketch and show depths.

GROUND LEVEL

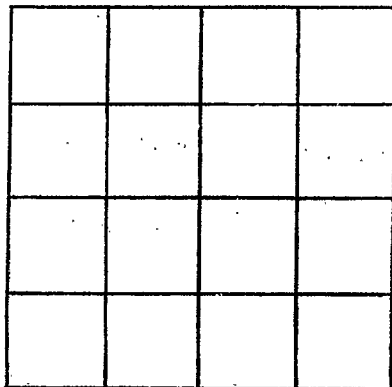

SECTION _____

Please indicate well location X.

ADDITIONAL INFORMATION

If more than one screen, show locations of each on sketch.