

Pearl River
P 2012
4-11-77

MISSISSIPPI
 BOARD OF WATER COMMISSIONERS
 416 North State Street
 Jackson, Mississippi 39201

WATER WELL DRILLERS LOG

4-11 1977 Bud Center Pearl River
 date well completed firm name county well located

LANDOWNER:
Diagnolic Wood Inc
Nicholson miss
 (mailing address)

description of formations encountered	from	to
<u>Red shale</u>	<u>0</u>	<u>46</u>
<u>bed sand</u>	<u>46</u>	<u>95</u>
<u>gray shale</u>	<u>95</u>	<u>175</u>
<u>gray sand</u>	<u>175</u>	<u>190</u>

WELL LOCATION:
 sec. 21 T. 4 N R. 17 E
 3 3 W
 (distance) (direction) of Nicholson
 (nearest town)

WELL PURPOSE: home
 (home, irrigation, municipal, industrial)

- WELL COMPLETION DATA:
- (1) diameter (inches) 2 1/2 in
 - (2) total depth (feet) 190
 - (3) static water level (feet) _____ below/above top of ground.
 - (4) casing PVC, 180,
 (material) (depth)
 (size) If telescope see back.
 - (5) screen 10, 180
 (length) (depth to top)
2 in, PVC
 (size) (material)
 - (6) pump 1 (HP) (yield gpm).
electric
 (type power)
 - (7) electric log no
 (yes or no)

(organization running log)
 (8) how well bottom plugged
hard shale


DRILLERS REMARKS:

RECEIVED

MISS. BD. OF WATER COMMISSIONERS

If well telescopes please
sketch and show depths.

GROUND LEVEL

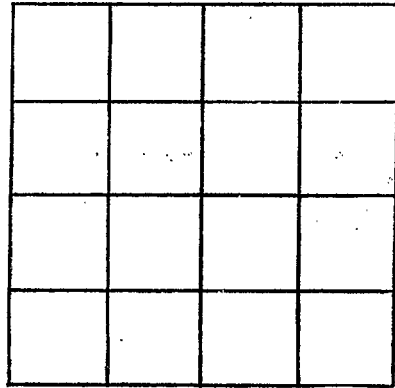

SECTION _____

Please indicate well location X.

ADDITIONAL INFORMATION

If more than one screen,
show locations of each on sketch.