

Pearl River
 P 2013
 5/9/77

MISSISSIPPI
 BOARD OF WATER COMMISSIONERS
 416 North State Street
 13V Jackson, Mississippi 39201

WATER WELL DRILLERS LOG

579 date well completed
 1977 Bed poston Adam Pearl River county well located
 firm name

LANDOWNER:	description of formations encountered	from	to
Mr Earnest Wise	Red shale	0	22
A.T-1 Carrieville (mailing address)	Red sand	22	88


WELL LOCATION:
 sec. 24 T 4 N R 17 E
 64 miles N West of Carrieville
 (distance) (direction) (nearest town)

WELL PURPOSE: home
 (home, irrigation, municipal, industrial)

- WELL COMPLETION DATA:
- (1) diameter (inches) 4"
 - (2) total depth (feet) 85 ft
 - (3) static water level (feet) 45 below top of ground.
 - (4) casing pvc, 75 (material) (depth)
 - (size) If telescope see back.
 - (5) screen 4x10, 75 (length) (depth to top)
 - (size) (material)
 - (6) pump 1/2 pvc (HP) (yield gpm)
 - 660
 - (type power)
 - (7) electric log NO (yes or no)

(organization running log)
 (8) how well bottom plugged
 Shovel

DRILLERS REMARKS:

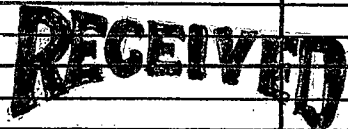

If well telescopes please sketch and show depths.

GROUND LEVEL

			X

SECTION _____

Please indicate well location X.

ADDITIONAL INFORMATION

If more than one screen, show locations of each on sketch.