

Pearl River  
P 2014  
6-17-77

MISSISSIPPI  
 BOARD OF WATER COMMISSIONERS  
 416 North State Street  
 130 Jackson, Mississippi 39201

WATER WELL DRILLERS LOG  
 STOCKSTILL BROS., INC.

Pearl River

6-17-77

date well completed

firm name

county well located

LANDOWNER:  
Mr. Owen Frouse  
15. Brentwood Rd  
Metairie, La  
 (mailing address)

description of formations encountered	from	to
Clay	0	15
Sand	15	160
Clay	160	200
Sand	200	280
Clay	280	360
Sand	360	480

WELL LOCATION:  
 sec. 2 T 4 N R 17 E  
3 miles NW of McNeil  
 (distance) (direction) (nearest town)

WELL PURPOSE: Home  
 (home, irrigation, municipal, industrial)

- WELL COMPLETION DATA:
- (1) diameter (inches) 9"
  - (2) total depth (feet) 480'
  - (3) static water level (feet) 7 below above top of ground.
  - (4) casing P.V.C., 475'  
 (material) (depth)  
2" If telescope see back.  
 (size)
  - (5) screen 5', 475'  
 (length) (depth to top)  
9", P.V.C.  
 (size) (material)
  - (6) pump 1/2, 18  
 (HP) (yield gpm)  
Elec.  
 (type power)
  - (7) electric log No  
 (yes or no)  
No  
 (organization running log)
  - (8) how well bottom plugged Sand Shale


**RECEIVED**  
 SEP 22 1977

MISS. BD. OF WATER COMMISSIONERS

DRILLERS REMARKS:

If well telescopes please sketch and show depths.

GROUND LEVEL

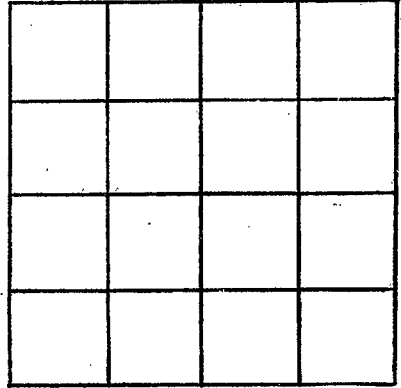

SECTION \_\_\_\_\_

Please indicate well location X.

ADDITIONAL INFORMATION

A series of horizontal lines for providing additional information.

If more than one screen, show locations of each on sketch.