

Pearl R.
 P 2015
 8/2/77

MISSISSIPPI
 BOARD OF WATER COMMISSIONERS
 416 North State Street
 Jackson, Mississippi 39201

WATER WELL DRILLERS LOG

8-2 date well completed 1977 Bud Carter firm name Pearl River county well located

LANDOWNER:
 Wayne Mitchell
 Carver, Mo.
 (mailing address)

description of formations encountered	from	to
Red Shale	0	60
Red Sand & Rock	60	90
Blue Shale	90	260
Grey Sand	260	280

WELL LOCATION:
 sec. 19 T-4 N R-17 E
 6 miles W of Carver
 (distance) (direction) (nearest town)

WELL PURPOSE: Home
 (home, irrigation, municipal, industrial)

- WELL COMPLETION DATA:
- (1) diameter (inches) 4 in
 - (2) total depth (feet) 280
 - (3) static water level (feet) 120 ^{below} top of ground
 - (4) casing PVC 270
 (material) (depth)
 (size) if telescope see back.
 - (5) screen 2x10 270
 (length) (depth to top)
 12 PVC
 (size) (material)
 - (6) pump 1 850
 (HP) (yield gpm)
 electric
 (type power)
 - (7) electric log NO 119ppm
 (yes or no)

(organization running log)
 (8) how well bottom plugged
 Sand Slack


DRILLERS REMARKS:

RECEIVED

DEC 30 1977

If well telescopes please sketch and show depths.

GROUND LEVEL

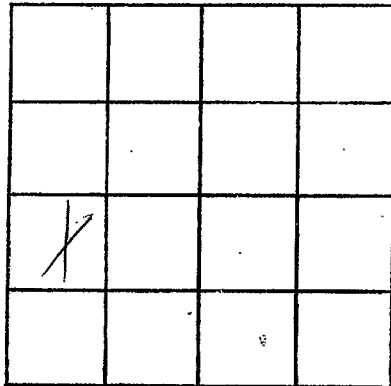

SECTION _____

Please indicate well location X.

ADDITIONAL INFORMATION

If more than one screen,
show locations of each on sketch.