

Pearl River
P 2071
10-19-77

MISSISSIPPI
 BOARD OF WATER COMMISSIONERS
 416 North State Street
 Jackson, Mississippi 39201

WATER WELL DRILLERS LOG

10-19- 1977 Stackwell Bros. Inc. Pearl River
 date well completed firm name county well located

LANDOWNER:
Mr. Richard Bounds
Carrier, Miss.
 (mailing address)

WELL LOCATION:
 sec. 15 T. 4 N. R. 17 E.
5 miles N.W. of McNeil
 (distance) (direction) (nearest town)

WELL PURPOSE: Home
 (home, irrigation, municipal, industrial)

- WELL COMPLETION DATA:
- (1) diameter (inches) 2"
 - (2) total depth (feet) 502'
 - (3) static water level (feet) 60' below above top of ground.
 - (4) casing P.V.C., 492'
 (material) (depth)
2" if telescope see back.
 (size)
 - (5) screen 10', 492'
 (length) (depth to top)
2", P.V.C.
 (size) (material)
 - (6) pump 1hp, 1200
 (HP) (yield gpm)
Elec
 (type power)
 - (7) electric log No
 (yes or no)
No
 (organization running log)
 - (8) how well bottom plugged Sand Shale

description of formations encountered	from	to
Clay	0	15
Sand	15	25
Clay	25	75
Sand	75	90
Clay	90	125
Sand	125	240
Clay	240	400
Sand	400	502

DRILLERS REMARKS:


RECEIVED

OCT 25 1977

MISS. BD. OF WATER COMM.

If well telescopes please sketch and show depths.

GROUND LEVEL

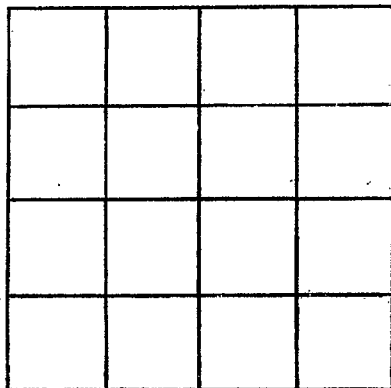

SECTION _____

Please indicate well location X.

ADDITIONAL INFORMATION

If more than one screen, show locations of each on sketch.