

PEARL RIVER
P 209

MISSISSIPPI
 BOARD OF WATER COMMISSIONERS
 416 North State Street
 Jackson, Mississippi 39201

WATER WELL DRILLERS LOG

2/13 1978 B. B. Benton & Son Pearl River
 date well completed firm name county well located

LANDOWNER: Johny Pullins
Box 1, Box 283 E
Carriere Miss
 (mailing address)

description of formations encountered	from	to
<u>Red shale</u>	<u>0</u>	<u>35</u>
<u>White sand</u>	<u>35</u>	<u>30</u>

WELL LOCATION:
 sec. 28 T. 4 N. R. 17 E
3 miles W of Carriere
 (distance) (direction) (nearest town)

WELL PURPOSE:
 (home, irrigation, municipal, industrial)

- WELL COMPLETION DATA:
- (1) diameter (inches) 4"
 - (2) total depth (feet) 80 ft.
 - (3) static water level (feet) 42 below above top of ground.
 - (4) casing PVC 70
 (material) (depth)
70 if telescope see back.
 (size)
 - (5) screen 4x10 70
 (length) (depth to top)
12 PVC
 (size) (material)
 - (6) pump 1/2 750
 (HP) (yield gpm)
Elect
 (type power)
 - (7) electric log NO
 (yes or no)

(organization running log)

(8) how well bottom plugged good


DRILLERS REMARKS:
J. Pullins

RECEIVED
 JUL 14 1978

MISS. BD. OF WATER COMM

If well telescopes please sketch and show depths.

GROUND LEVEL

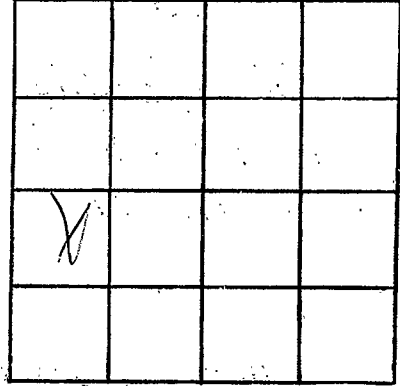

SECTION _____

Please indicate well location X.

ADDITIONAL INFORMATION

If more than one screen, show locations of each on sketch.