

PEARL RIVER
 P 2020

MISSISSIPPI
 BOARD OF WATER COMMISSIONERS
 416 North State Street
 Jackson, Mississippi 39201

WATER WELL DRILLERS LOG

3 2 19 78 Pouncey Water well Pearl River
 date well completed firm name Driller county well located

LANDOWNER: Dan Spiers
 RFD - McAdill MS.
 (mailing address)
 WELL LOCATION:
 sec 34 T 4 N R 17 E
 S W
 5 miles W of McAdill
 (distance) (direction) (nearest town)


description of formations encountered	from	to
Clay	0	8
Sd & Rocks Horms	8	40
Clay	400	100
Sd & Rocks - gnd	100	230

WELL PURPOSE: Home
 (home, irrigation, municipal, industrial)

WELL COMPLETION DATA:

(1) diameter (inches) 2
 (2) total depth (feet) 230
 (3) static water level (feet) 22 below top of ground
 (4) casing PVC 220 (material) (depth)
 2 (size) If telescope see back.
 (5) screen 10 220 (length) (depth to top)
 2 PVC (size) (material)
 (6) pump 1/2 8 (HP) (yield gpm)
 AC 115 (type power)
 (7) electric log (yes or no)
 (organization running log)
 (8) how well bottom plugged Subd.


DRILLERS REMARKS: good well

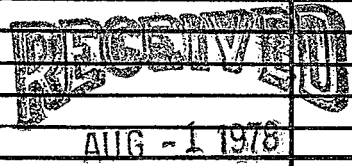

MISS. BD. OF WATER COMMISSIONERS

If well telescopes please sketch and show depths.

GROUND LEVEL

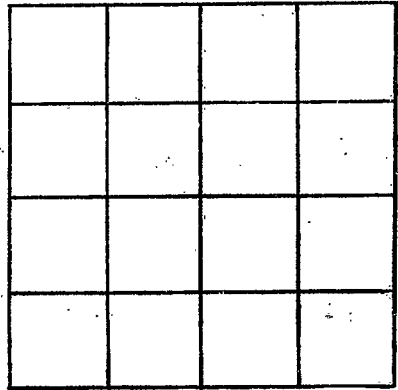

SECTION _____

Please indicate well location X.

ADDITIONAL INFORMATION

If more than one screen, show locations of each on sketch.