

PEARL RIVER

P 2021

MISSISSIPPI BOARD OF WATER COMMISSIONERS
416 North State Street
Jackson, Mississippi 39201

WATER WELL DRILLERS LOG

3/20 1978 *Paul R. Price* firm name *Paul R. Price* county well located

LANDOWNER: *James Diggins*
R T-1 Carriere
Miss
(mailing address)

description of formations encountered	from	to
<i>Red shale</i>	<i>0</i>	<i>36</i>
<i>Red sand</i>	<i>36</i>	<i>41</i>
<i>Shale</i>	<i>41</i>	<i>160</i>
<i>White sand</i>	<i>160</i>	<i>175</i>

WELL LOCATION:
sec. *19* T. *4* N. R. *17* E. ?
S. W.
4 1/2 miles *W* of *Carriere*
(distance) (direction) (nearest town)


WELL PURPOSE: *Home*
(home, irrigation, municipal, industrial)

- WELL COMPLETION DATA:
- (1) diameter (inches) *2"*
 - (2) total depth (feet) *175*
 - (3) static water level (feet) *51* below above top of ground.
 - (4) casing *PVC*, *165'* (material) (depth)
70 If telescope see back. (size)
 - (5) screen *2x8*, *165'* (length) (depth to top)
12, *PVC* (size) (material)
 - (6) pump *1* (HP) *450* (yield gpm).
Elect (type power)
 - (7) electric log *no* (yes or no)

(organization running log)

(8) how well bottom plugged *not*

DRILLERS REMARKS: *Sharp*

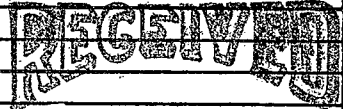

JUL 14 1978

MISSISSIPPI BOARD OF WATER COMMISSIONERS

