

PEARL RIVER

P 2022

MISSISSIPPI
 BOARD OF WATER COMMISSIONERS
 416 North State Street
 Jackson, Mississippi 39201

WATER WELL DRILLERS LOG

3/4 1978 Red Automation Paul Wiley
 date well completed firm name county well located

LANDOWNER: Wayne Mitchell
A.F. 1 Box 151
Carriere Miss.
 (mailing address)

Description of formations encountered	from	to
<u>Red shale</u>	<u>0</u>	<u>36</u>
<u>Red sand</u>	<u>36</u>	<u>48</u>
<u>Blue shale</u>	<u>48</u>	<u>270</u>
<u>Red sand</u>	<u>270</u>	<u>270</u>


WELL LOCATION:
 sec. 19 T 4 N R. 17 E ?
 S W S W
4 1/2 miles W of Carriere
 (distance) (direction) (nearest town)

WELL PURPOSE: Home
 (home, irrigation, municipal, industrial)

- WELL COMPLETION DATA:
- (1) diameter (inches) 4"
 - (2) total depth (feet) 270
 - (3) static water level (feet) 139 below top of ground.
 - (4) casing pvc, 260
 (material) (depth)
2 1/2" if telescope see back.
 (size)
 - (5) screen 4x10, 260
 (length) (depth to top)
12, pvc
 (size) (material)
 - (6) pump 1, 650
 (HP) (yield gpm)
Electric
 (type power)
 - (7) electric log no
 (yes or no)

(organization running log)
 (8) how well bottom plugged
Sealed


DRILLERS REMARKS:

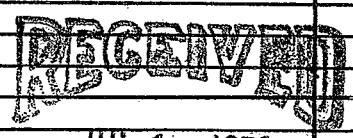

JUL 11 1978

If well telescopes please sketch and show depths.

GROUND LEVEL

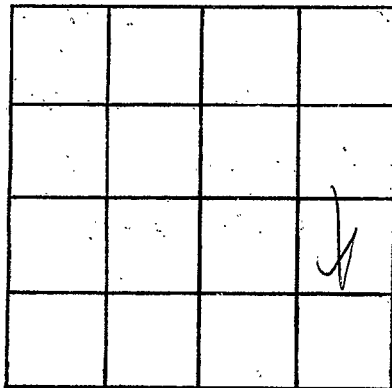

SECTION _____

Please indicate well location X.

ADDITIONAL INFORMATION

If more than one screen,
show locations of each on sketch.