

PEARL RIVER

P 2023

MISSISSIPPI
 BOARD OF WATER COMMISSIONERS
 416 North State Street
 Jackson, Mississippi 39201

WATER WELL DRILLERS LOG

3/1 1978 Bud Penton & Son Pearl River
 date well completed firm name county well located

LANDOWNER: Mr. Bill Scheraga
 B.T. 1 Bot 149
 Carriere Miss.
 (mailing address)

description of formations encountered	from	to
Red shale	0	41
Red sand	41	50
Grey shale	50	240
Grey sand	240	288

WELL LOCATION:
 sec. 19 T 4 N R 17 E
 4 miles W of Carriere
 (distance) (direction) (nearest town)

WELL PURPOSE: Home
 (home, irrigation, municipal, industrial)

WELL COMPLETION DATA:

(1) diameter (inches) 2"

(2) total depth (feet) 288

(3) static water level (feet) 149 below top of ground

(4) casing 400 (material), 278 (depth)
 NO if telescope see back. (size)


(5) screen 2x10 (length), 278 (depth to top)
 12 (size), SS Steel (material)

(6) pump 1/2 (HP), 350 (yield gpm)
 Elect (type power)

(7) electric log NO (yes or no)

(8) how well bottom plugged
 (organization running log)

DRILLERS REMARKS:

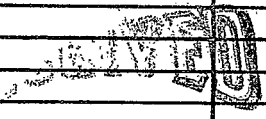


JUL 14 1978

MISS. BD. OF WATER COMM

If well telescopes please
sketch and show depths.

GROUND LEVEL

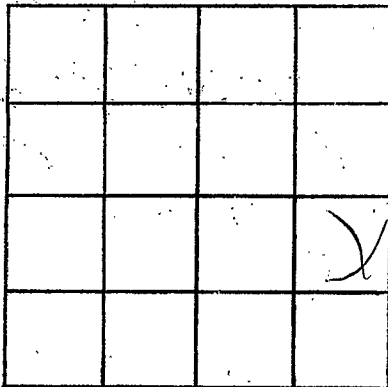

SECTION _____

Please indicate well location X.

ADDITIONAL INFORMATION

If more than one screen,
show locations of each on sketch.