

PEARL RIVER

P 2024

MISSISSIPPI BOARD OF WATER COMMISSIONERS  
416 North State Street  
Jackson, Mississippi 39201

WATER WELL DRILLERS LOG

8/3

date well completed

1978 Bid Penton & Sons Pearl River

firm name

county well located

LANDOWNER: Jan Jones

R. T. Bot

description of formations encountered

Red shale  
Red sand  
Gray shale  
Gray sand

from to

0 30  
30 38  
38 230  
230 273

(mailing address)

WELL LOCATION:

sec. 19 T 4 N R 17 E ?  
S W

6 miles W of Carriere  
(distance) (direction) (nearest town)

WELL PURPOSE: Home  
(home, irrigation, municipal, industrial)


WELL COMPLETION DATA:

- (1) diameter (inches) 4"
- (2) total depth (feet) 275
- (3) static water level (feet) 126 below above top of ground.
- (4) casing PVC, 265'  
(material) (depth)  
30 if telescope see back.  
(size)
- (5) screen 4x10, 265'  
(length) (depth to top)  
1/2", PVC  
(size) (material)
- (6) pump 1 650  
(HP) (yield gpm)  
Elect  
(type power)
- (7) electric log Yes  
(yes or no)

(organization running log)

(8) how well bottom plugged hard


DRILLERS REMARKS:

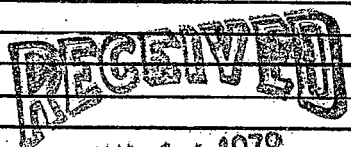

JUL 14 1978

If well telescopes please sketch and show depths.

GROUND LEVEL

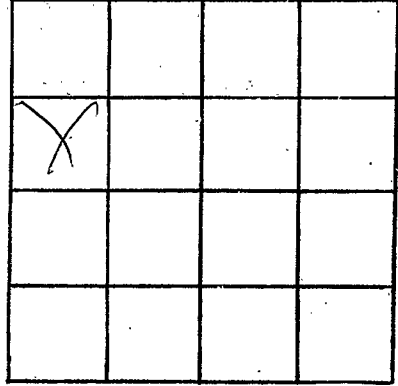

SECTION \_\_\_\_\_

Please indicate well location X.

ADDITIONAL INFORMATION

Lined area for additional information, consisting of approximately 20 horizontal lines.

If more than one screen, show locations of each on sketch.