

MISSISSIPPI DEPARTMENT OF NATURAL RESOURCES

Bureau of Land and Water Resources

Southport Mall

P.O. Box 10631

Jackson, Mississippi 39209

WATER WELL DRILLERS LOG

Pearl River
P 20027
12/8/80

12-8
 date well completed

1980 Penton Well Serv
 firm name

Pearl River
 county well located

LANDOWNER: Mrs. Lois Thomas
Rt. 1
Carriere MISS.
 (mailing address)

description of formations encountered	from	to
Surface Clay	0	20
Mud	20	40
Blue clay	40	140
Sand	140	178

WELL LOCATION:
 sec. 15 T-4 S R-17 W
5 miles N.W. of McNeil
 (distance) (direction) (nearest town)

WELL PURPOSE: HOME
 (home, irrigation, municipal, industrial)

- WELL COMPLETION DATA:
- (1) diameter (inches) 2"
 - (2) total depth (feet) 178'
 - (3) static water level (feet) 61' ~~above~~ below top of ground.
 - (4) casing Galv ~~173'~~ 173'
 (material) (depth)
2" if telescope see back.
 (size)
 - (5) screen 5' 173'
 (length) (depth to top)
2" (size) (material)
 - (6) pump 1 7
 (HP) (yield gpm)
Elec
 (type power)
 - (7) electric log NO
 (yes or no)
 (organization running log)
 - (8) how well bottom plugged BSV Valve

DRILLERS REMARKS:


DEPT. OF NATURAL RESOURCES
 BUREAU OF LAND & WATER RESOURCES

DEC 15 1980

RECEIVED

If well telescopes please sketch and show depths.

GROUND LEVEL

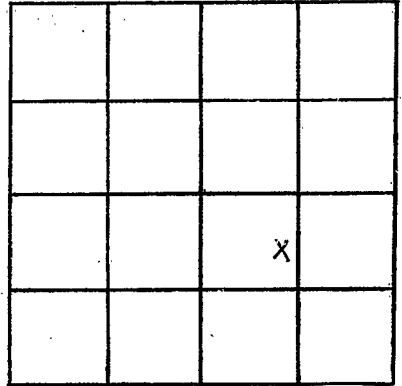

SECTION 15

Please indicate well location X.

ADDITIONAL INFORMATION

If more than one screen, show locations of each on sketch.