


PEARL RIVER
P 2022

MISSISSIPPI
BOARD OF WATER COMMISSIONERS
416 North State Street
Jackson, Mississippi 39201

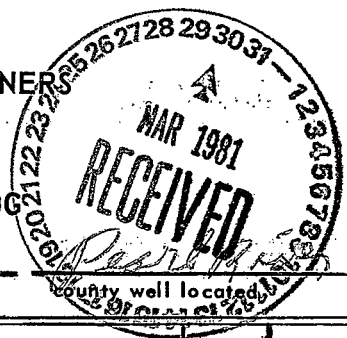

2-26-81

WATER WELL DRILLERS LOG

2/26 1981 Bud Penton
date well completed: 2/26/81
firm name: Water Well Service

county well located: Pearl River

LANDOWNER: Dan Gunner
B.T. & Bot 67AA
Carriere Miss.
(mailing address)

description of formations encountered	from to	
	feet	feet
Red shale	0	35
Blue shale	35	220
Blue sand	220	275
Blue shale	275	480
Gray sand	480	523

WELL LOCATION:
sec. 19 T-4 N R-17 E
8 miles W of Carriere
(distance) (direction) (nearest town)


WELL PURPOSE: none
(home, irrigation, municipal, industrial)

- WELL COMPLETION DATA:
- (1) diameter (inches) 4"
 - (2) total depth (feet) 523
 - (3) static water level (feet) 120 below top of ground.
 - (4) casing PVC, 523 (depth)
(material) (depth)
 - (size) if telescope see back.
 - (5) screen 10, 573 (length) (depth to top)
12, PVC (size) (material)
 - (6) pump 1, 650 (HP) (yield gpm/h)
Elect (type power)
 - (7) electric log no. (yes or no)
 - (organization running log)
 - (8) how well bottom plugged: Shale sand

DRILLERS REMARKS:

If well telescopes please sketch and show depths.

GROUND LEVEL

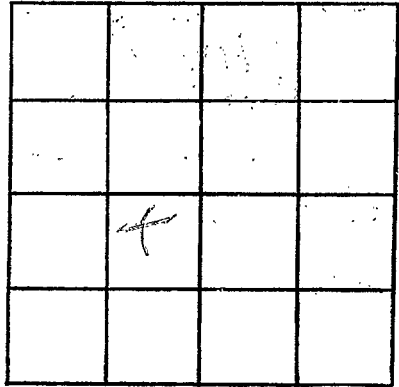

SECTION _____

Please indicate well location X.

ADDITIONAL INFORMATION

If more than one screen, show locations of each on sketch.