

PEARL RIVER  
D 2030  
3/31/81

MISSISSIPPI  
BOARD OF WATER COMMISSIONERS  
416 North State Street  
Jackson, Mississippi 39201

WATER WELL DRILLERS LOG

date well completed 3/31 1981 Budington Waters Pearl River  
Well Service firm name county well located

LANDOWNER: Jim Allison  
R.T. 1 McNeil  
(mailing address)


description of formations encountered	from	to
white shale	0	12
white sand	12	70
blue shale	70	175
gray sand	175	245
blot shale	245	350
gray sand	350	415

WELL LOCATION:  
sec. 17 T. 4 N. R. 17 E  
7 miles west of McNeil  
(distance) (direction) (nearest town)

WELL PURPOSE: home  
(home, irrigation, municipal, industrial)

- WELL COMPLETION DATA:
- (1) diameter (inches) 4 1/2
  - (2) total depth (feet) 415
  - (3) static water level (feet) 8 below top of ground.
  - (4) casing PVC 415 (material) (depth)  
4 1/2 (size) If telescope see back.
  - (5) screen 4 1/2 x 15 (length) 400 (depth to top)  
1 1/2 (size) PVC (material)
  - (6) pump 70 (HP) (yield gpm)  
(type power)
  - (7) electric log no (yes or no)  
(organization running log)
  - (8) how well bottom plugged sand

DRILLERS REMARKS: no pump  
summed

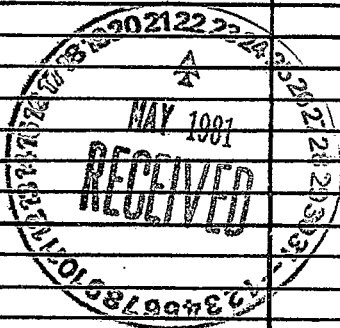


4  
-  
20  
13

If well telescopes please sketch and show depths.

GROUND LEVEL

Ref. 120

356-

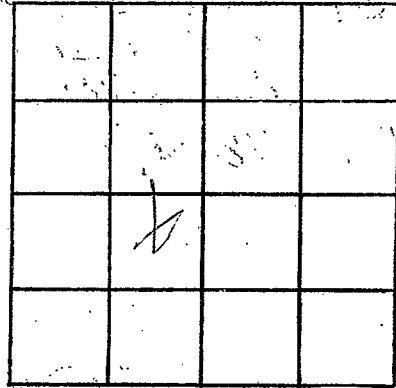

SECTION \_\_\_\_\_

Please indicate well location X.

ADDITIONAL INFORMATION

Lined area for additional information.

If more than one screen, show locations of each on sketch.