

PEARL RIVER  
P 2031  
3/26/81

MISSISSIPPI  
BOARD OF WATER COMMISSIONERS  
416 North State Street  
Jackson, Mississippi 39201

WATER WELL DRILLERS LOG

3/26/81 1981 Bud Penton Water Pearl River  
3/26/81 date well completed well drilled firm name Pearl River county well located


LANDOWNER: W. H. Wells  
Kinda R. J. - 2 Box  
Carriere Miss.  
(mailing address)

description of formations encountered	from	to
<u>Red shale</u>	<u>0</u>	<u>60</u>
<u>Red sand</u>	<u>60</u>	<u>85</u>
<u>Blue shale</u>	<u>85</u>	<u>140</u>
<u>gray sand</u>	<u>140</u>	<u>285</u>

WELL LOCATION:  
sec. 12 T 4 N R 17 E  
S W  
7 miles West of Carriere  
(distance) (direction) (nearest town)

WELL PURPOSE: drain  
(home, irrigation, municipal, industrial)

- WELL COMPLETION DATA:
- (1) diameter (inches) 4"
  - (2) total depth (feet) 285
  - (3) static water level (feet) 160 below top of ground.
  - (4) casing PVC 285  
(material) (depth)  
(size) if telescope see back.
  - (5) screen 4x10 225  
(length) (depth to top)  
12 PVC  
(size) (material)
  - (6) pump 3/4 650  
(HP) (yield-gpm)  
Elect  
(type power)
  - (7) electric log no  
(yes or no)
  - (organization running log)
  - (8) how well bottom plugged Shut

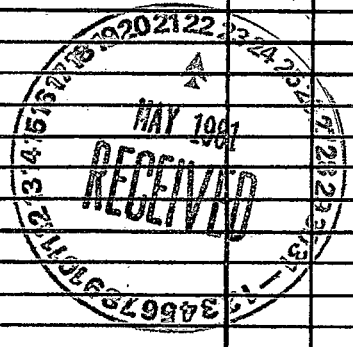

DRILLERS REMARKS:

If well telescopes please sketch and show depths.

GROUND-LEVEL

f			

SECTION \_\_\_\_\_

Please indicate well location X.

ADDITIONAL INFORMATION

If more than one screen, show locations of each on sketch.