

MISSISSIPPI DEPARTMENT OF NATURAL RESOURCES

Bureau of Land and Water Resources

Southport Mall

P.O. Box 10631

Jackson, Mississippi 39209

WATER WELL SERVICE DRILLERS LOG

ROUTE 3 BOX 41

CARRIERS, MS 39426


PHONE 798-5324

P. River  
Pa033  
6-23-81

6/23 1981  
date well completed


Forest Pines  
county well located

LANDOWNER: <i>Joe. Picayune</i> <i>Rt. 3 Box 379</i> <i>Picayune Miss.</i> (mailing address)	description of formations encountered	from	to
	<i>white shale</i>	<i>0</i>	<i>12</i>
	<i>white sand</i>	<i>12</i>	<i>96</i>
	<i>blue shale</i>	<i>96</i>	<i>320</i>
	<i>gray sand</i>	<i>320</i>	<i>375</i>
WELL LOCATION:			
sec. <i>23</i> T. <i>4</i> N R. <i>17</i> E S W			
<i>8</i> miles <i>West</i> of <i>Picayune</i> (distance) (direction) (nearest town)			
WELL PURPOSE: <i>home</i> (home, irrigation, municipal, industrial)			
WELL COMPLETION DATA:			
(1) diameter (inches) <i>2 1/2</i>			
(2) total depth (feet) <i>375</i>			
(3) static water level (feet) <i>7</i> below above top of ground.			
(4) casing <i>pvc</i> <i>375</i> (material) (depth)			
(size) if telescope see back.			
(5) screen <i>10</i> <i>365</i> (length) (depth-to-top)			
<i>12</i> <i>pvc</i> (size) (material)			
(6) pump <i>1/2</i> <i>450</i> (HP) (yield gpm)			
<i>Elect</i> (type power)			
(7) electric log <i>no</i> (yes or no)			
(organization running log)			
(8) how well bottom plugged <i>sand shock</i>			
DRILLERS REMARKS:			

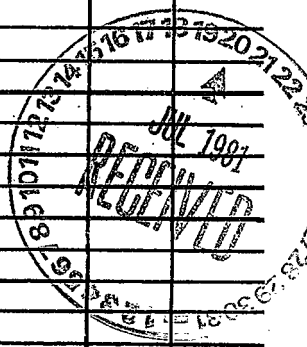

If well telescopes please sketch and show depths.

GROUND LEVEL

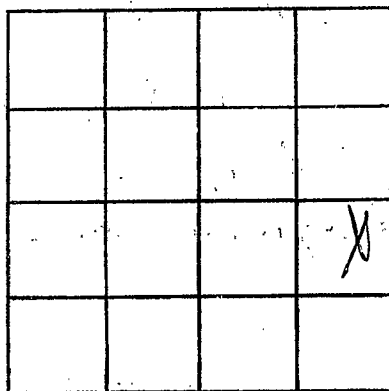

SECTION \_\_\_\_\_

Please indicate well location X.

ADDITIONAL INFORMATION

If more than one screen, show locations of each on sketch.