

MISSISSIPPI DEPARTMENT OF NATURAL RESOURCES
Bureau of Land and Water Resources
Southport Mall
P.O. Box 10631
Jackson, Mississippi 39209
WATER WELL DRILLERS LOG

Pearl River
P 2034
7-28-81

July 28 1981 ~~Clear Lake, Polk County~~ Pearl River
date well completed Robert L. Schmidt county well located


LANDOWNER: Bob Aggarolla
3213 Florida Ave.
Kenner La. 70062
(mailing address)

description of formations encountered	from to	
	feet	feet
top Soil	0"	3"
Red clay gravel	3'	13'
Red sand gravel	13'	15'
Yellow sand (lith. gravel)	15'	17'
Yellow sand	17'	20'
Yellow sand gravel clay	20'	30'
gray sand (lith. gravel)	30'	100'
gray sand gravel	100'	130'
gray sand (lith. white sand)	130'	200'
loose white sand gravel	200'	250'

WELL LOCATION:
sec 5 T 4 N R 17 E
(distance) miles SW (direction) of Poplarville (nearest town)

WELL PURPOSE: name
(home, irrigation, municipal, industrial)


- WELL COMPLETION DATA:
- diameter (inches) 2"
 - total depth (feet) 250
 - static water level (feet) 80 below above top of ground.
 - casing PVC (material), 250' (depth)
_____ if telescope see back.
(size)
 - screen 10" (length), 240" (depth to top)
012" (size), PVC (material)
 - pump 1 (HP), 9 (yield gpm)
220V AC (type power)
 - electric log _____
(yes or no)
_____ (organization running log)
 - how well bottom plugged Sand Stone

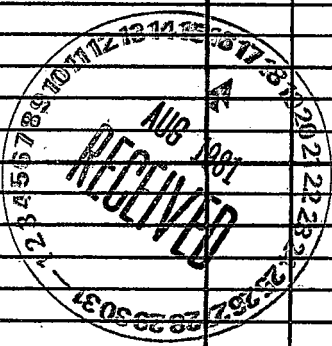

DRILLERS REMARKS: _____

If well telescopes please sketch and show depths.

GROUND LEVEL

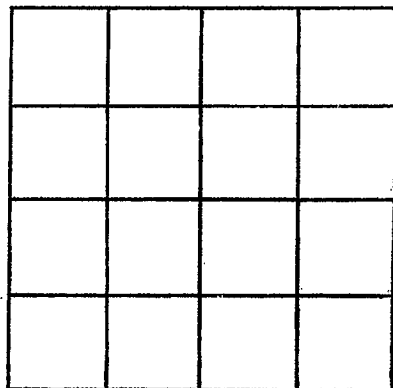

SECTION _____

Please indicate well location X.

ADDITIONAL INFORMATION

If more than one screen,
show locations of each on sketch.