

MISSISSIPPI DEPARTMENT OF NATURAL RESOURCES

Bureau of Land and Water Resources

Southport Mall

P.O. Box 10631

Jackson, Mississippi 39209

WATER WELL DRILLERS LOG

Pearl River  
P 2035  
11-13-81

Nov 13 1981 Walker Well Drilling Shop Pearl River  
date well completed firm name county well located

LANDOWNER: Dudley Smith  
B1 - Coahoma Miss  
(mailing address)

WELL LOCATION:  
sec. 12 T. 4 N. R. 17 W. S. W.  
16 miles NE of Prichard  
(distance) (direction) (nearest town)

WELL PURPOSE: Small  
(home, irrigation, municipal, industrial)

WELL COMPLETION DATA:  
(1) diameter (inches) 2"  
(2) total depth (feet) 275'  
(3) static water level (feet) 168' below above top of ground.  
(4) casing PVC, 265'  
(material) (depth)  
(size) if telescope see back.  
(5) screen 10', 265'  
(length) (depth to top)  
15", PVC  
(size) (material)  
(6) pump 1 1/2, 7  
(HP) (yield gpm)  
Electric  
(type power)  
(7) electric log (yes or no)

(organization running log)  
(8) how well bottom plugged Small  
about

DRILLERS REMARKS:

description of formations encountered	from	to
Red shale	0	14
fine sand	14	22
prichard	22	24
white shale	24	235
Coahoma	235	275


DEPT. OF NATURAL RESOURCES  
BUREAU OF LAND & WATER RESOURCES

NOV 23 1981

RECEIVED

If well telescopes please sketch and show depths.

GROUND LEVEL

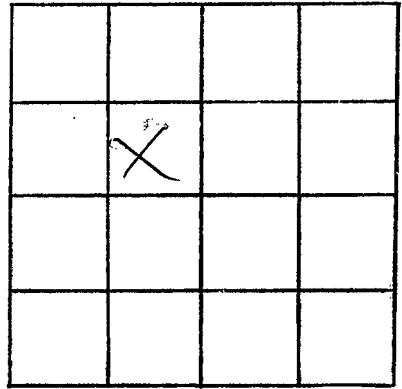

SECTION \_\_\_\_\_

Please indicate well location X.

ADDITIONAL INFORMATION

If more than one screen,  
show locations of each on sketch.