

MISSISSIPPI DEPARTMENT OF NATURAL RESOURCES

Bureau of Land and Water Resources

Southport Mall

P.O. Box 10631

Jackson, Mississippi 39209

WATER WELL DRILLERS LOG

Dec 7 1981 Walton Welding Panola
 date well completed firm name county well located

LANDOWNER	description of formations encountered	from	to
<u>Jean Smith Bank</u> <u>R. 1, Cammie Miss</u> (mailing address)	<u>Red shale</u>	<u>0</u>	<u>58</u>
	<u>fine sand</u>	<u>58</u>	<u>72</u>
	<u>Blue shale</u>	<u>72</u>	<u>195</u>
	<u>Coarse sand layers</u>	<u>195</u>	<u>220</u>
WELL LOCATION:			
sec <u>38</u> T <u>4</u> N R <u>13</u> W <u>15</u> miles <u>NE</u> <u>Panola</u> (distance) (direction) (nearest town)			
WELL PURPOSE: <u>Home</u> (home, irrigation, municipal, industrial)			
WELL COMPLETION DATA:			
(1) diameter (inches) <u>2 1/2</u>			
(2) total depth (feet) <u>220</u>			
(3) static water level (feet) <u>120</u> <small>below above</small> top of ground.			
(4) casing <u>PVC</u> , <u>210</u> (material) (depth) (size) if telescope see back.			
(5) screen <u>10</u> , <u>210</u> (length) (depth to top)			
(6) pump <u>12</u> , <u>PVC alt</u> (size) (material)			
(6) pump <u>1</u> , <u>3</u> (HP) (yield gpm)			
<u>Electric</u> (type power)			
(7) electric log (yes or no) (organization running log)			
(8) how well bottom plugged <u>Sand plug</u>			
DRILLERS REMARKS:			


DEPT. OF NATURAL RESOURCES
 BUREAU OF LAND & WATER RESOURCES

JAN 8 - 1982

RECEIVED

If well telescopes please sketch and show depths.

GROUND LEVEL

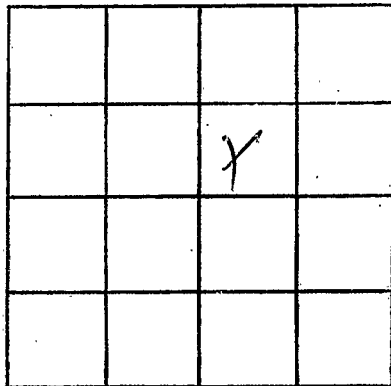

SECTION _____

Please indicate well location X.

ADDITIONAL INFORMATION

If more than one screen,
show locations of each on sketch.