

MISSISSIPPI DEPARTMENT OF NATURAL RESOURCES
 Bureau of Land and Water Resources
 Southport Mall
 P.O. Box 10631
 Jackson, Mississippi 39209
WATER WELL DRILLERS LOG

Pearl River
 P
 2037

5-4-82 date well completed WALKER'S WELDING and Repair Pearl River Co firm name county well located

LANDOWNER: RICHARD CAMPBELL

description of formations encountered from to

RT-1

CARRIERE MISS
 (mailing address)

Red Shell 0 63
 Course Sand 63 90

WELL LOCATION:
 sec. 18 T 4 S R 17 E
 18 miles NW of PRAYNE
 (distance) (direction) (nearest town)

WELL PURPOSE: HOME
 (home, irrigation, municipal, industrial)

WELL COMPLETION DATA:

- (1) diameter (inches) 4"
- (2) total depth (feet) 90'
- (3) static water level (feet) 60' below top of ground.
- (4) casing PVC 80'
 (material) (depth)
- (size) if telescope see back.
- (5) screen 10' 80'
 (length) (depth to top)
- (size) 15 PVC
 (size) (material)
- (6) pump 1/2 7
 (HP) (yield gpm)
- Elec
 (type power)
- (7) electric log (yes or no)

(organization running log)

(8) how well bottom plugged: SAND SAFETY

DRILLERS REMARKS:


DEPT. OF NATURAL RESOURCES
 BUREAU OF LAND & WATER RESOURCES

MAY 10 1982

RECEIVED

If well telescopes please sketch and show depths.

GROUND LEVEL

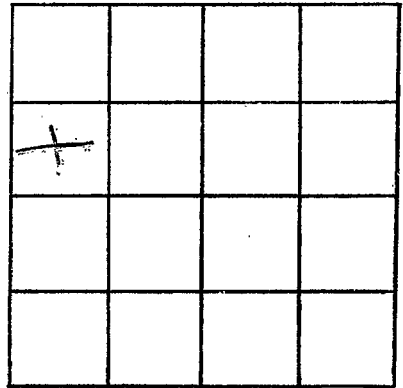

SECTION _____

Please indicate well location X.

ADDITIONAL INFORMATION

If more than one screen,
show locations of each on sketch.