

MISSISSIPPI DEPARTMENT OF NATURAL RESOURCES

Bureau of Land and Water Resources

Southport Mall

P.O. Box 10631

Jackson, Mississippi 39209

WATER WELL DRILLERS LOG

Real River  
Pool

3-12-83 19 Walker Welding firm name Plan River county well located  
date well completed

LANDOWNER: <u>Don Banks</u>	description of formations encountered	from	to
<u>Caminus Mist</u>  (mailing address)	<u>Red shell</u> <u>Sand gravel</u>	<u>0</u> <u>12</u>	<u>12</u> <u>55</u>
<b>WELL LOCATION:</b>			
sec. <u>25</u> T <u>4</u> N R <u>17</u> W S W <u>15</u> miles <u>NW</u> of <u>Princeton</u> (distance) (direction) (nearest town)			
<b>WELL PURPOSE:</b> <u>HOME</u>			
(home, irrigation, municipal, industrial)			
<b>WELL COMPLETION DATA:</b>			
(1) diameter (inches) <u>4"</u>			
(2) total depth (feet) <u>55'</u>			
(3) static water level (feet) <u>14</u> below above top of ground.			
(4) casing <u>PVC</u> , <u>55'</u> (material) (depth)			
(size) if telescope see back.			
(5) screen <u>10'</u> , <u>45'</u> (length) (depth to top)			
<u>12</u> , <u>PVC</u> (size) (material)			
(6) pump <u>1/4</u> , <u>10</u> (HP) (yield gpm)			
<u>Elec.</u> (type power)			
(7) electric log (yes or no)			
(organization running log)			
(8) how well bottom plugged <u>Sand</u> <u>shrub</u>			
DRILLERS REMARKS:			


DEPT. OF NATURAL RESOURCES  
BUREAU OF LAND & WATER RESOURCES

APR - 4 1983

RECEIVED

If well telescopes please  
sketch and show depths.

GROUND LEVEL

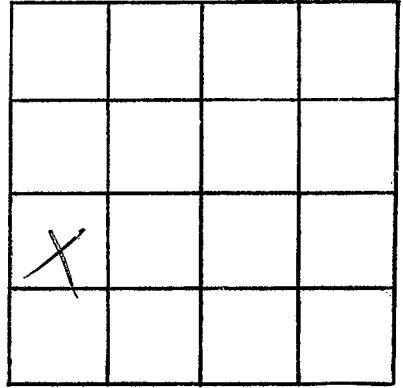

SECTION \_\_\_\_\_

Please indicate well location X.

ADDITIONAL INFORMATION

If more than one screen,  
show locations of each on sketch.