

MISSISSIPPI DEPARTMENT OF NATURAL RESOURCES

Bureau of Land and Water Resources

Pearl River
Pool

BUD PENTON & SON
WATER WELL SERVICE
ROUTE 4 BOX 402
CARRIERE, MS 39423
PHONE 793-6924

Southport Mall
P.O. Box 1063
ROUTE BOX
CARRIERE, MS 39423
PHONE 793-6924

WATER WELL DRILLERS LOG

8/5 1983 date well completed pearl river firm name pearl river county well located

| LANDOWNER: | description of formations encountered | from | to |
|----------------------|---------------------------------------|------------|------------|
| <u>Curtis Drey</u> | <u>Red shale</u> | <u>0</u> | <u>30</u> |
| <u>A.T. Carriere</u> | <u>Red sand</u> | <u>30</u> | <u>45</u> |
| <u>Miss</u> | <u>Blue shale</u> | <u>45</u> | <u>400</u> |
| (mailing address) | <u>Gray sand</u> | <u>400</u> | <u>441</u> |

WELL LOCATION:
sec. 33 T 4 N R 17 E
S W
6 miles W of Carriere
(distance) (direction) (nearest town)

WELL PURPOSE: home
(home, irrigation, municipal, industrial)

- WELL COMPLETION DATA:
- (1) diameter (inches) 2"
 - (2) total depth (feet) 441
 - (3) static water level (feet) 40 below above top of ground.
 - (4) casing POG, 441
(material) (depth)
 - _____ if telescope see back.
(size)
 - (5) screen 10, 431
(length) (depth to top)
 - 12, POG
(size) (material)
 - (6) pump 1, 82
(HP) (yield gpm)
 - Ele
(type power)
 - (7) electric log no
(yes or no)

_____ (organization running log)

(8) how well bottom plugged Sharp

DRILLERS REMARKS:


DEPT. OF NATURAL RESOURCES
BUREAU OF LAND & WATER RESOURCES

NOV 18 1983

RECEIVED

If well telescopes please sketch and show depths.

GROUND LEVEL

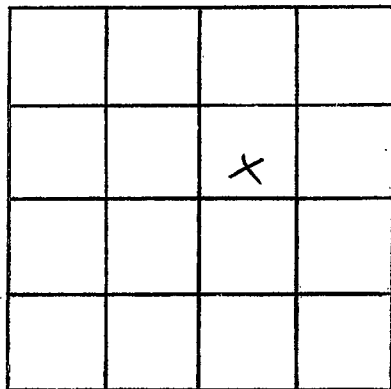

SECTION _____

Please indicate well location X.

ADDITIONAL INFORMATION

If more than one screen, show locations of each on sketch.