

MISSISSIPPI DEPARTMENT OF NATURAL RESOURCES

Bureau of Land and Water Resources

BUD PENTON & SON  
WATER WELL SERVICE  
ROUTE 4 BOX 1607  
CARRIERE, MS 39223  
PHONE 793-5324

SOUTHPORT MALL  
P.O. Box 10631  
CARRIERE, MS 39223  
PHONE 793-5324

WATER WELL DRILLERS LOG

WATER WELL SERVICE  
ROUTE 4 BOX 1607  
CARRIERE, MS 39223  
PHONE 793-5324

Pearl River  
P2042

10/18 1983  
date well completed

Pearl River  
county well located

LANDOWNER: Jack Bassler  
R.T. 1 Box 2 82 Poplarville  
Miss 39470  
(mailing address)

| description of formations encountered | from       | to         |
|---------------------------------------|------------|------------|
| <u>Red shale</u>                      | <u>0</u>   | <u>30</u>  |
| <u>Red sand</u>                       | <u>30</u>  | <u>82</u>  |
| <u>Blue shale</u>                     | <u>82</u>  | <u>210</u> |
| <u>Gray sand</u>                      | <u>210</u> | <u>330</u> |
| <u>Blue shale</u>                     | <u>330</u> | <u>456</u> |
| <u>Gray sand</u>                      | <u>456</u> | <u>578</u> |

WELL LOCATION:  
sec. 18 T 4 N R 17 E  
S W  
10 miles W of McNeal  
(distance) (direction) (nearest town)

WELL PURPOSE: home  
(home, irrigation, municipal, industrial)

- WELL COMPLETION DATA:
- (1) diameter (inches) 4"
  - (2) total depth (feet) 578
  - (3) static water level (feet) 70 below top of ground.
  - (4) casing pvc, 578  
(material) (depth)
  - (size) If telescope see back.
  - (5) screen 4'x10, 578  
(length) (depth to top)
  - (size) 1/2", pvc  
(size) (material)
  - (6) pump no  
(HP) (yield gpm)
  - (type power)
  - (7) electric log no  
(yes or no)
  - (organization running log)

(8) how well bottom plugged hard  
shark


DRILLERS REMARKS:  
no pump furnished

DEPT. OF NATURAL RESOURCES  
BUREAU OF LAND & WATER RESOURCES

NOV 18 1983  
RECEIVED

If well telescopes please sketch and show depths.

GROUND LEVEL

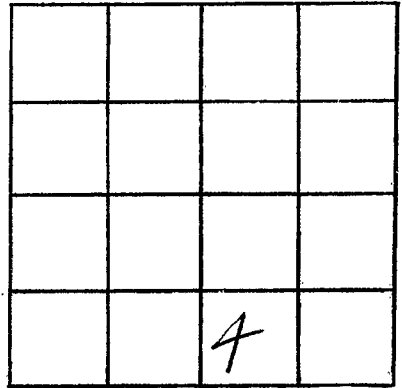

SECTION \_\_\_\_\_

Please indicate well location X.

ADDITIONAL INFORMATION

If more than one screen,  
show locations of each on sketch.