

Pearl River  
P 2043

MISSISSIPPI  
BOARD OF WATER COMMISSIONERS  
416 North State Street  
Jackson, Mississippi 39201

WATER WELL DRILLERS LOG

10 - 84<sup>7</sup> 19 | Stogge Well Ser | Pearl River  
date well completed | firm name | county well located

LANDOWNER: <u>Charlie Knapp</u> <u>Poplarville, Miss</u> (mailing address)	description of formations encountered	from	to
WELL LOCATION: sec. <u>4</u> T <u>4</u> N R <u>17</u> E <u>20</u> miles <u>SW</u> of <u>Poplarville</u> (distance) (direction) (nearest town)	<u>top soil</u>	<u>0</u>	<u>2</u>
	<u>Red clay</u>	<u>2</u>	<u>140</u>
WELL PURPOSE: (home, irrigation, municipal, industrial)	<u>clay sand</u>	<u>140</u>	<u>160</u>
	<u>fine sand</u>	<u>160</u>	<u>180</u>
WELL COMPLETION DATA: (1) diameter (inches) <u>4"</u> (2) total depth (feet) <u>290 ft.</u> (3) static water level (feet) <u>180</u> <sup>below</sup> / <sub>above</sub> top of ground (4) casing <u>Plastic</u> (material), <u>280 ft.</u> (depth) <u>4"</u> (size) if telescope see back. (5) screen <u>10 ft.</u> (length), <u>280</u> (depth to top) <u>4"</u> (size), <u>Plastic</u> (material) (6) pump <u>1</u> (HP), <u>18</u> (yield gpm) <u>Elect</u> (type power) (7) electric log <u>(yes or no)</u> <u>(organization running log)</u> (8) how well bottom plugged <u>BWW</u>	<u>white chalk</u>	<u>180</u>	<u>250</u>
	<u>fine sand</u>	<u>250</u>	<u>270</u>
DRILLERS REMARKS: <u>[Signature]</u>	<u>sand &amp; gravel</u>	<u>270</u>	<u>290</u>


DEPT. OF NATURAL RESOURCES  
BUREAU OF LAND & WATER RESOURCES

JAN 23 1984

RECEIVED

If well telescopes please sketch and show depths.

GROUND LEVEL

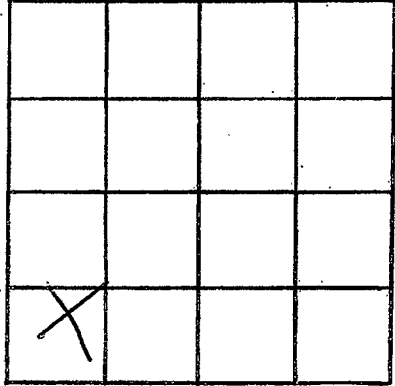

SECTION 4

Please indicate well location X.

ADDITIONAL INFORMATION

If more than one screen,  
show locations of each on sketch.