

MISSISSIPPI DEPARTMENT OF NATURAL RESOURCES

Bureau of Land and Water Resources

Southport Mall

P.O. Box 10631

Jackson, Mississippi 39209

WATER WELL DRILLERS LOG

PEARL RIVER
P 2045

1/30 1984 Bud Penton Water Well Pearl River
date well completed firm name county well located

LANDOWNER: Bill A. Mocher
B-7-5 B105
Paplarville Miss.
(mailing address)

description of formations encountered	from	to
<u>Red shale</u>	<u>0</u>	<u>23</u>
<u>White sand</u>	<u>23</u>	<u>75</u>

WELL LOCATION:
sec. 3 T 25 N R 17 E
67 miles N of McNeill
(distance) (direction) (nearest town)

WELL PURPOSE: home
(home, irrigation, municipal, industrial)

- WELL COMPLETION DATA:
- (1) diameter (inches) 2"
 - (2) total depth (feet) 75
 - (3) static water level (feet) 2 below above top of ground.
 - (4) casing PVC, 75
(material) (depth)
12 If telescope see back.
(size)
 - (5) screen 5, 70
(length) (depth to top)
12, PVC
(size) (material)
 - (6) pump 1/2, 65-0
(HP) (yield gpm)
Electric
(type power)
 - (7) electric log no
(yes or no)
Shark
(organization running log)
 - (8) how well bottom plugged Shark

DEPT. OF NATURAL RESOURCES
BUREAU OF LAND & WATER RESOURCES


JUL 10 1984

RECEIVED

DRILLERS REMARKS:

If well telescopes please sketch and show depths.

GROUND LEVEL

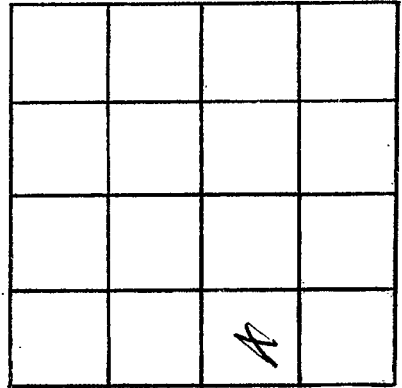

SECTION _____

Please indicate well location X.

ADDITIONAL INFORMATION

If more than one screen,
show locations of each on sketch.