

Pearl River
P2046

MISSISSIPPI DEPARTMENT OF NATURAL RESOURCES

BUD PENTO Bureau of Land and Water Resources
 WATER WFL SERVICE Southport Mall
 ROUTE BOX C CARRIERE, MS 39209 P. O. Box 10631
 PHONE 783-5324 JACKSON, MISSISSIPPI 39209

WATER WELL DRILLERS LOG

7/22 1984
 date well completed

Pearl River
 county well located

LANDOWNER: jeon smith
R.T. 1 Carrier
miss -
 (mailing address)

description of formations encountered

from

to

Red shale 0 90
Blue shale 90 300
Blue sand 300 320
Blue shale 320 470
Gray sand 470 502

WELL LOCATION:

sec. 19 T 4 N R. 17 E
6 miles N of Carrier
 (distance) (direction) (nearest town)

WELL PURPOSE: home
 (home, irrigation, municipal, industrial)

WELL COMPLETION DATA:

- (1) diameter (inches) 4"
- (2) total depth (feet) 502
- (3) static water level (feet) 135 below top of ground.
- (4) casing pvc, 502,
 (material) (depth)
 (size) If telescope see back.
- (5) screen 10 1/2, 492
 (length) (depth to top)
10, pvc
 (size) (material)
- (6) pump 1 850
 (HP) (yield gpm)
Elect
 (type power)
- (7) electric log no
 (yes or no)

(organization running log)

(8) how well bottom plugged shard


DRILLERS REMARKS:

DEPT. OF NATURAL RESOURCES
 BUREAU OF LAND & WATER RESOURCES

DEC - 2 1984
 RECEIVER

If well telescopes please sketch and show depths.

GROUND LEVEL

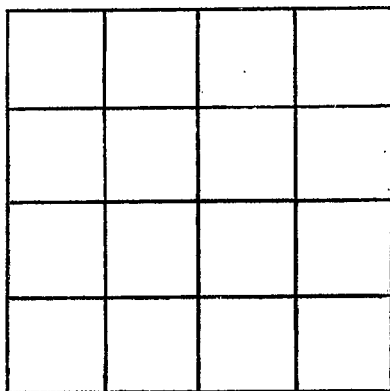

SECTION _____

Please indicate well location X.

ADDITIONAL INFORMATION

If more than one screen, show locations of each on sketch.