

P2057
 PEARL RIVER
 3-15-85

MISSISSIPPI DEPARTMENT OF NATURAL RESOURCES
 Bureau of Land and Water Resources
 Southport Mall
 P.O. Box 10631
 Jackson, Mississippi 39209
 WATER WELL DRILLERS LOG

3-15-85 date well completed
 85 WALKERS WELDING & REPAIR firm name
 P.R. county well located

LANDOWNER: ALOPHUS NEFF
KT. 1
CARRIERS, MS.
 (mailing address)
 WELL LOCATION:
 sec. 5 T 4 S R. 17 W
15 miles NW of PEARL RIVER
 (distance) (PEARL RIVER) (nearest town)
 WELL PURPOSE: HOME
 (home, irrigation, municipal, industrial)

description of formations encountered	from	to
CLAY	0	20
SAND	20	26
CLAY	26	141
SAND	141	181

WELL COMPLETION DATA:
 (1) diameter (inches) 2"
 (2) total depth (feet) 181
 (3) static water level (feet) 70 below above top of ground.
 (4) casing PVC, 171
 (material) (depth)
 _____ if telescope see back.
 (size)
 (5) screen 10, 171
 (length) (depth to top)
12, PVC
 (size) (material)
 (6) pump 1 HP, 8
 (HP) (yield gpm)
ELECT
 (type power)
 (7) electric log _____
 (yes or no)


 (organization running log)
SANDSARK
 (8) how well bottom plugged

DRILLERS REMARKS:

RECEIVED
 APR 17 1985
 Department of Natural Resources
 Bureau of Land & Water Resources

If well telescopes please sketch and show depths.

GROUND LEVEL

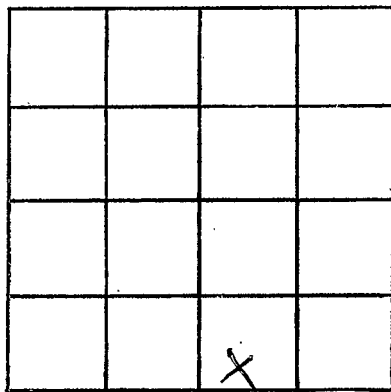

SECTION _____

Please indicate well location X.

ADDITIONAL INFORMATION

If more than one screen, show locations of each on sketch.