

MISSISSIPPI DEPARTMENT OF NATURAL RESOURCES
 Bureau of Land and Water Resources
 Southport Mall
 P.O. Box 10631
 Jackson, Mississippi 39209
 WATER WELL DRILLERS LOG

P2048
PEARL RIVER
3-18-85

3-18 19 85 WALKERS WELDING & REPAIR PR
 date well completed firm name county well located

LANDOWNER: <u>CHARLES USNER</u>	description of formations encountered		from	to
<u>RT. 1</u>	<u>CLAY</u>		<u>0</u>	<u>22</u>
<u>CARRIERE, MS.</u> (mailing address)	<u>SAND</u>		<u>22</u>	<u>30</u>
<u>WELL LOCATION:</u>	<u>CLAY</u>		<u>30</u>	<u>145</u>
sec. <u>6</u> T. <u>9</u> S. R. <u>17</u> W.	<u>SAND</u>		<u>145</u>	<u>180</u>
<u>15</u> miles <u>N.W.</u> of <u>PICAYUNE</u> (distance) <u>WALTON</u> (nearest town)	<u>GRAVEL</u>		<u>180</u>	<u>185</u>
<u>WELL PURPOSE: HOME</u> (home, irrigation, municipal, industrial)				
<u>WELL COMPLETION DATA:</u>				
(1) diameter (inches) <u>2"</u>				
(2) total depth (feet) <u>185</u>				
(3) static water level (feet) <u>78</u> below top of ground.				
(4) casing <u>PVC</u> <u>175</u> (material) (depth)				
(size) If telescope see back.				
(5) screen <u>10'</u> <u>175</u> (length) (depth to top)				
<u>12</u> <u>PVC</u> (size) (material)				
(6) pump <u>1</u> <u>8</u> (HP) (yield gpm)				
<u>ELECTRIC</u> (type power)				
(7) electric log (yes or no) _____				
(organization running log) _____				
(8) how well bottom plugged <u>SANDSHARK</u>				


RECEIVED
 APR 17 1985

Department of Natural Resources
 Bureau of Land & Water Resources

DRILLERS REMARKS: _____

If well telescopes please sketch and show depths.

GROUND LEVEL

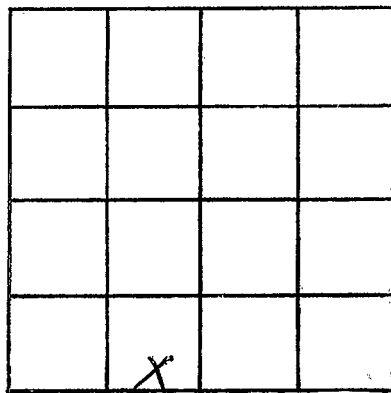

SECTION _____

Please indicate well location X.

ADDITIONAL INFORMATION

If more than one screen, show locations of each on sketch.