

MISSISSIPPI DEPARTMENT OF NATURAL RESOURCES

Bureau of Land and Water Resources

Southport Mall

P.O. Box 10631

Jackson, Mississippi 39209

WATER WELL DRILLERS LOG

DP 2009
PEARL RIVER
4-1-85

4-1 1985 WALKERS WELDING & REPAIR PR.
 date well completed firm name county well located

LANDOWNER HENRY HASSEL VAN DER
1340 BINNARAL BLVD
MATHURIE LA. 70005
 (mailing address)

Description of formations encountered	from	to
CLAY	0	36
SAND	36	44
CLAY	44	78
SAND	78	132
GRAVEL	132	140

WELL LOCATION:
 sec. 2 T. 4 S. R. 17 W.
8 miles NW MENEIL
 (distance) (direction) (nearest town)

WELL PURPOSE: HOME
 (home, irrigation, municipal, industrial)

- WELL COMPLETION DATA:
- (1) diameter (inches) 4"
 - (2) total depth (feet) 140
 - (3) static water level (feet) 68 below above top of ground.
 - (4) casing PVC 130
 (material) (depth)
 _____ if telescope see back.
 (size)
 - (5) screen 10 130
 (length) (depth to top)
12 PVC
 (size) (material)
 - (6) pump 1 18
 (HP) (yield gpm)
ELECTRIC
 (type power)
 - (7) electric log _____
 (organization running log)
 - (8) how well bottom plugged SANDSHARK


RECEIVED
 APR 17 1985

DRILLERS REMARKS: _____

Department of NATURAL Resources
 Bureau of Land & Water Resources

If well telescopes please sketch and show depths.

GROUND LEVEL

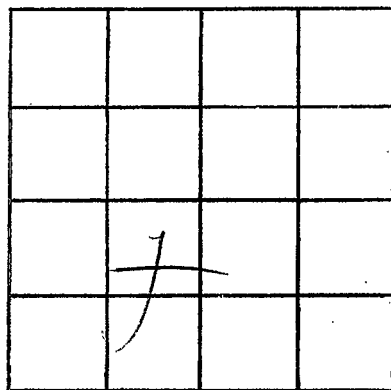

SECTION _____

Please indicate well location X.

ADDITIONAL INFORMATION

If more than one screen,
show locations of each on sketch.