

MISSISSIPPI DEPARTMENT OF NATURAL RESOURCES

Bureau of Land and Water Resources

Southport Mall

P.O. Box 10631

BUD PENTON & SONS

Jackson, Mississippi 39209

Water Well Drillers Log

Rt. 4, Box 402

Carriere, Mississippi 39426

Phone 601 708-5324

Pearl River
P 2050
3/20/85

3/20

date well completed

1985

Pearl River
county well located

LANDOWNER:

Marvin Smith

B.T. 4 Carriere Triss

39426

(mailing address)

WELL LOCATION:

sec. 4 T. 4 N. R. 17 E.

8 miles NE of McNeil
(distance) (direction) (nearest town)

WELL PURPOSE:

house

(home, irrigation, municipal, industrial)

WELL COMPLETION DATA:

- (1) diameter (inches) 2"
- (2) total depth (feet) 473
- (3) static water level (feet) 30 below above top of ground.
- (4) casing PVC, 473,
(material) (depth)
NO if telescope see back.
(size)
- (5) screen 10, 463
(length) (depth to top)
12, PVC
(size) (material)
- (6) pump NO
(HP) (yield gpm)

(type power)

(7) electric log (yes or no)

(organization running log)

(8) how well bottom plugged hard
sharp

DRILLERS REMARKS:

no pump
surveys

description of formations encountered	from	to
Red shale	0	60
Red sand	60	85
Blue shale	85	220
Gray sand	220	285
Blue shale	285	420
Gray sand	420	473


RECEIVED

JUN - 6 1985

Department of Natural Resources
Bureau of Land & Water Resources

If well telescopes please sketch and show depths.

GROUND LEVEL

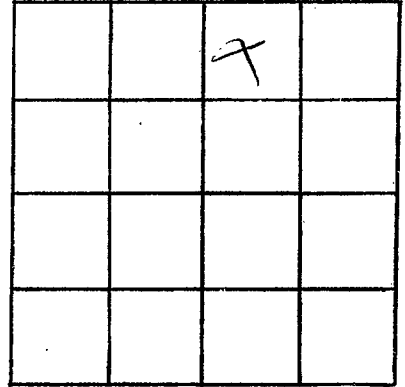

SECTION _____

Please indicate well location X.

ADDITIONAL INFORMATION

If more than one screen,
show locations of each on sketch.