

MISSISSIPPI DEPARTMENT OF NATURAL RESOURCES

BUD PENTON & SONS

Bureau of Land and Water Resources

Water Well Services

Southport Mall

Rt. 4, Box 102

P.O. Box 10631

Carriere, Mississippi 39426

Jackson, Mississippi 39209

Phone 601-796-5322

WATER WELL DRILLERS LOG

Pearl River
P 2051
4/19/85

4/19 1985

date well completed

firm name

Pearl River
 county well located

LANDOWNER: Robert Spivey
Rt 4 Box Carriere
39426
 (mailing address)

description of formations encountered

Red shale
Red sand

from to
8/17
10/60

WELL LOCATION:

sec 28 T 4 N R 17 E
6 miles W of McNeil
 (distance) (direction) (nearest town)

WELL PURPOSE: home
 (home, irrigation, municipal, industrial)

WELL COMPLETION DATA:

- (1) diameter (inches) 2 1/2
- (2) total depth (feet) 66
- (3) static water level (feet) 20 below above top of ground.
- (4) casing pvc 60
 (material) (depth)
no if telescope see back.
 (size)
- (5) screen 10 50
 (length) (depth to top)
1/4 pvc
 (size) (material)
- (6) pump 1 100
 (HP) (yield gpm)
Elect 19 gpm
 (type power)
- (7) electric log no
 (yes or no)

(organization running log)

(8) how well bottom plugged plugged
shale

DRILLERS REMARKS:


RECEIVED

JUN 22 1985

Department of Natural Resources
 Bureau of Land & Water Resources

If well telescopes please
sketch and show depths.

GROUND LEVEL

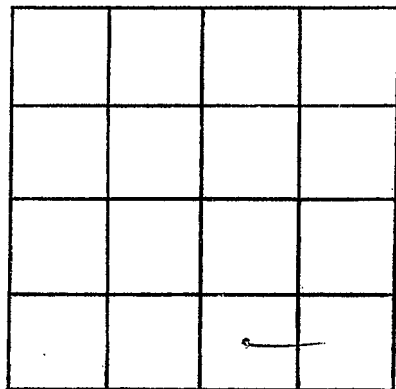

SECTION _____

Please indicate well location X.

ADDITIONAL INFORMATION

If more than one screen,
show locations of each on sketch.