

MISSISSIPPI DEPARTMENT OF NATURAL RESOURCES

Bureau of Land and Water Resources

Southport Mall

P.O. Box 10631

Jackson, Mississippi 39209

BUD PENTON & SONS WATER WELL DRILLERS LOG

Pearl River
P 2052
4/26/85

4/26 1985
date well completed

Water Well Service
Rt. 4, Box 402
Carriere, Mississippi 39426

Pearl River
county well located

LANDOWNER: Charles Belcher

Phone 01 - 798-5324
description of formations encountered

Rt. 1 Carriere
Miss - 39426
(mailing address)

description of formations encountered	from	to
Red shale	0	30
Red sand	30	60
Blue shale	60	220
Gray sand	220	300
Blue shale	300	408
Gray sand	408	455

WELL LOCATION:

sec 27 T-4 N R-17 E
6 miles S of Mc Neal
(distance) (direction) (nearest town)

WELL PURPOSE: home
(home, irrigation, municipal, industrial)

WELL COMPLETION DATA:

- (1) diameter (inches) 4"
- (2) total depth (feet) 455
- (3) static water level (feet) 30 below
top of ground
- (4) casing PVC 455'
(material) (depth)
no (size) if telescope see back.
- (5) screen 10 445'
(length) (depth to top)
12 PVC
(size) (material)
- (6) pump 1/2 600
(HP) (yield gpm)
Elect. 109 gpm
(type power)
- (7) electric log no
(yes or no)

(organization running log)

(8) how well bottom plugged
Sand
Shale

RECEIVED


JUN - 6 1985

Department of Natural Resources
Bureau of Land & Water Resources

DRILLERS REMARKS:

If well telescopes please sketch and show depths.

GROUND LEVEL

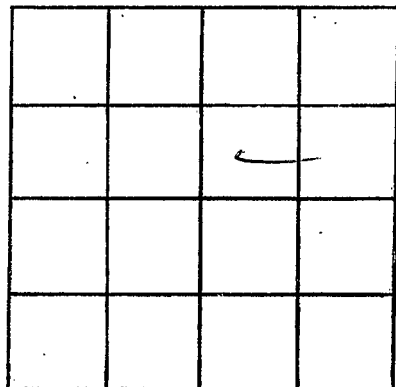

SECTION _____

Please indicate well location X.

ADDITIONAL INFORMATION

If more than one screen,
show locations of each on sketch.