

MISSISSIPPI DEPARTMENT OF NATURAL RESOURCES

Bureau of Land and Water Resources

Southport Mall

P.O. Box 10631

BUD PENTON & SONS

Water Well Drillers Log

Rt. 4, Box 402

Carriere, Mississippi 39426

Phone 601 - 798-5324

county well located

Pearl River  
P 2053  
5/29/85

5/29 1985  
date well completed

LANDOWNER:

Gilley Smith

Rt. 1 Carriere, Miss

39426

(mailing address)

description of formations encountered

Red Shell  
Red Sand

from

to

0 15'  
15 6.3

WELL LOCATION:

sec. 25 T 4 N R 17 E  
6 miles W of Carriere  
(distance) (direction) (nearest town)

WELL PURPOSE:

home  
(home, irrigation, municipal, industrial)

WELL COMPLETION DATA:

- (1) diameter (inches) 4"
- (2) total depth (feet) 63
- (3) static water level (feet) 30 below top of ground.
- (4) casing PVC 63 (material) (depth)
- no (size) if telescope see back.
- (5) screen 4x10 53 (length) (depth to top)
- 12 PVC (size) (material)
- (6) pump 1/2 600 log pm (HP) (yield gpm)
- Flt (type power)
- (7) electric log no (yes or no)

(organization running log)

(8) how well bottom plugged Lead  
Sand

DRILLERS REMARKS:


RECEIVED

JUN - 6 1985

Department of Natural Resources  
Bureau of Land & Water Resources

If well telescopes please sketch and show depths.

GROUND LEVEL

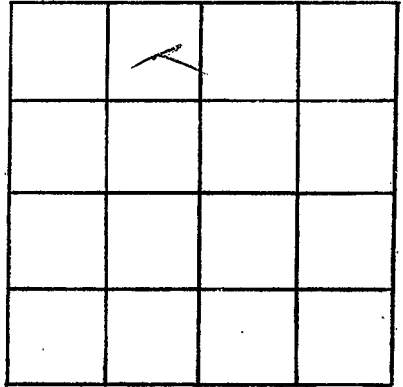

SECTION \_\_\_\_\_

Please indicate well location X.

ADDITIONAL INFORMATION

If more than one screen,  
show locations of each on sketch.