

MISSISSIPPI DEPARTMENT OF NATURAL RESOURCES

Bureau of Land and Water Resources

Southport Mall

P.O. Box 10631

Jackson, Mississippi 39209

WATER WELL DRILLERS LOG

PEARL RIVER
 20054

July 24-85 19 Walker Welding Pearl River
 date well completed firm name county well located

LANDOWNER: Gambel
R I Cannon
 (mailing address)

WELL LOCATION:
 sec 7 T 4 S R 17 E W
15 miles NW Princeton
 (distance) (direction) (nearest town)

WELL PURPOSE: Home
 (home, irrigation, municipal, industrial)

- WELL COMPLETION DATA:
- (1) diameter (inches) 4"
 - (2) total depth (feet) 215'
 - (3) static water level (feet) 89 below
 top of ground. above
 - (4) casing PVC, 205'
 (material) (depth)
 (size) if telescope see back.
 - (5) screen 10', 205'
 (length) (depth to top)
10', PVC
 (size) (material)
 - (6) pump 1, 8
 (HP) (yield gpm)
Elec
 (type power)
 - (7) electric log (yes or no)
 - (organization running log)
 - (8) how well bottom plugged Sand
block

description of formations encountered	from	to
<u>Red clay</u>	<u>0</u>	<u>80</u>
<u>sand</u>	<u>80</u>	<u>84</u>
<u>Blue shale</u>	<u>84</u>	<u>160</u>
<u>sand</u>	<u>160</u>	<u>168</u>
<u>Blue shale</u>	<u>168</u>	<u>185</u>
<u>sand</u>	<u>185</u>	<u>215</u>

RECEIVED


AUG 20 1985

DRILLERS REMARKS:

Department of Natural Resources
 Bureau of Land & Water Resources

If well telescopes please sketch and show depths.

GROUND LEVEL

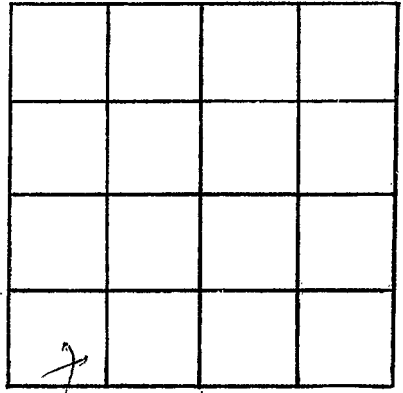

SECTION _____

Please indicate well location X.

ADDITIONAL INFORMATION

If more than one screen, show locations of each on sketch.