

**MISSISSIPPI DEPARTMENT OF NATURAL RESOURCES**  
 Bureau of Land and Water Resources  
 Southport Mall  
 P.O. Box 10631  
 Jackson, Mississippi 39209  
**WATER WELL DRILLERS LOG**

Pearl River  
Parcel

May 2 19 86 Wallace Welding Pearl River  
 date well completed firm name county well located

LANDOWNER: Lucille Brite

description of formations encountered

from to

RtE Box 630

Carriere Miss.  
 (mailing address)

Clay	0	68
Sand	13	68
Clay	68	150
Sand	150	203

**WELL LOCATION:**

sec 5 T 11 N R 17E  
                   S                  W  
15 miles NW of Picayune  
 (distance) (direction) (nearest town)


WELL PURPOSE: Home  
 (home, irrigation, municipal, industrial)

**WELL COMPLETION DATA:**

- (1) diameter (inches) 1 1/2"
- (2) total depth (feet) 203
- (3) static water level (feet) 150 below above top of ground.
- (4) casing PVC 186'  
 (material) (depth)  
 (size) if telescope see back.
- (5) screen #100 189'  
 (length) (depth to top)  
#100 PVC  
 (size) (material)
- (6) pump 1hp 18gpm  
 (HP) (yield gpm)  
 (type power)
- (7) electric log \_\_\_\_\_  
 (yes or no)  
 (organization running log)

(8) how well bottom plugged sand shark


DRILLERS REMARKS:

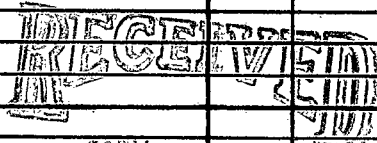

Department of Natural Resources  
 Bureau of Land and Water Resources

If well telescopes please sketch and show depths.

GROUND LEVEL

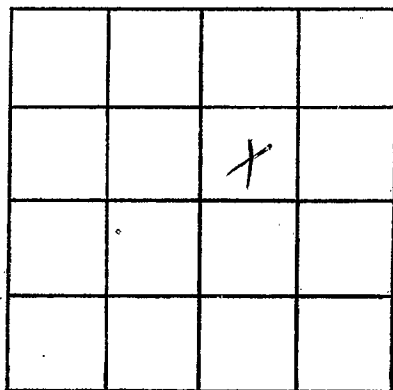

SECTION \_\_\_\_\_

Please indicate well location X.

ADDITIONAL INFORMATION

If more than one screen,  
show locations of each on sketch.