

MISSISSIPPI DEPARTMENT OF NATURAL RESOURCES

Bureau of Land and Water Resources

Southport Mall

P.O. Box 10631

Jackson, Mississippi 39209

WATER WELL DRILLERS LOG

PEARL RIVER
Parrot


8-9-86
date well completed

19 86

Walkers welding
firm name

Pearl River
county well located

LANDOWNER: <u>Mike Adams</u>	description of formations encountered	from	to
(mailing address)	white clay	0'	100'
	blue clay	100'	125'
	gray sand	125'	180'
<p>WELL LOCATION:</p> <p>sec. <u>2</u> T <u>4</u> N R <u>17</u> E</p> <p><u>17</u> miles <u>NW</u> of <u>Picayune</u></p> <p>(distance) (direction) (nearest town)</p>			
<p>WELL PURPOSE: <u>home</u></p> <p>(home, irrigation, municipal, industrial)</p>			
<p>WELL COMPLETION DATA:</p>			
(1) diameter (inches) <u>4"</u>			
(2) total depth (feet) <u>180'</u>			
(3) static water level (feet) <u>70'</u> below above top of ground.			
(4) casing <u>PVC</u> <u>160'</u> (material) (depth)			
<u> </u> if telescope see back. (size)			
(5) screen <u>#10</u> <u>160'</u> (length) (depth to top)			
<u>#10</u> <u>PVC</u> (size) (material)			
(6) pump <u>I</u> <u>20 gpm</u> (HP) (yield gpm)			
<u> </u> (type power)			
(7) electric log <u> </u> (yes or no)			
<u> </u> (organization running log)			
(8) how well bottom plugged <u>sand shark</u>			
DRILLERS REMARKS:			

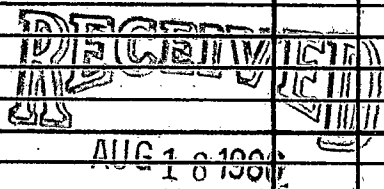


Department of Natural Resources
Bureau of Land & Water Resources

If well telescopes please sketch and show depths.

GROUND LEVEL

1000

1000
1000

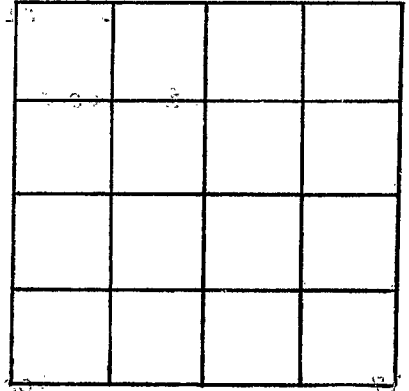

SECTION _____

Please indicate well location X.

ADDITIONAL INFORMATION

If more than one screen, show locations of each on sketch.