

MISSISSIPPI DEPARTMENT OF NATURAL RESOURCES

Bureau of Land and Water Resources

Southport Mall

P.O. Box 10631


Jackson, Mississippi 39209

WATER WELL DRILLERS LOG

PEARL RIVER  
20005

7-23 1986 PENTON WELL SERV. PEARL RIVER  
date well completed firm name county well located

LANDOWNER: <u>George Morrison</u>	description of formations encountered	from	to
<u>RT. 1 Box 690</u>			
<u>CARRIERS MS.</u> (mailing address)	<u>CLAY</u>	<u>0</u>	<u>110</u>
	<u>SAND</u>	<u>110</u>	<u>175</u>
	<u>CLAY</u>	<u>175</u>	<u>230</u>
	<u>SAND</u>	<u>230</u>	<u>300</u>
	<u>CLAY</u>	<u>300</u>	<u>520</u>
	<u>SAND</u>	<u>520</u>	<u>596</u>
WELL LOCATION: sec. <u>7</u> T. <u>4</u> S. R. <u>17</u> E. W. <u>3</u> miles <u>EAST</u> of <u>Hewlettsville</u> (distance) (direction) (nearest town)			
WELL PURPOSE: <u>HOME</u> (home, irrigation, municipal, industrial)			
WELL COMPLETION DATA:			
(1) diameter (inches) <u>4" x 2"</u>			
(2) total depth (feet) <u>596'</u>			
(3) static water level (feet) <u>60'</u> below above top of ground.			
(4) casing <u>PVC</u> , <u>586'</u> (material) (depth) <u>4" x 2"</u> if telescope see back. (size)			
(5) screen <u>10'</u> , <u>586'</u> (length) (depth to top) <u>2"</u> , <u>PVC</u> (size) (material)			
(6) pump <u>1</u> (HP) (yield gpm) <u>Elec</u> (type power)			
(7) electric log <u>NO</u> (yes or no) (organization running log)			
(8) how well bottom plugged <u>B.W.</u>			
DRILLERS REMARKS:			

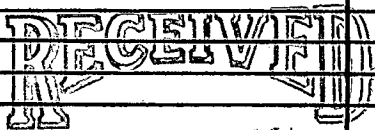

AUG 19 1986


Department of Natural Resources  
Bureau of Land & Water Resources

If well telescopes please sketch and show depths.

GROUND LEVEL

200 FT. 4" PVC

396 FT. 2" PVC

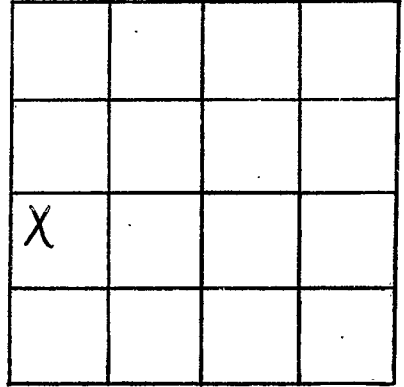

SECTION \_\_\_\_\_

Please indicate well location X.

ADDITIONAL INFORMATION

If more than one screen, show locations of each on sketch.