

MISSISSIPPI DEPARTMENT OF NATURAL RESOURCES

Bureau of Land and Water Resources

Southport Mall

P.O. Box 10631

Jackson, Mississippi 39209

WATER WELL DRILLERS LOG

PEARL RIVER
P 2060

8-13-86 1986
date well completed

Walker Welding
firm name

Pearl River
county well located

LANDOWNER:

Richard H. Hues

Rt. 1 Carrriere
(mailing address)

description of formations encountered

from to

Clay White

0 60

Dry Sand

60 100

Sand

100 168

WELL LOCATION:

sec. 7 T. 4 N. R. 14 W.

10 miles NW of Picayune
(distance) (direction) (nearest town)

WELL PURPOSE: home
(home, irrigation, municipal, industrial)

WELL COMPLETION DATA:

- (1) diameter (inches) 2"
- (2) total depth (feet) 168'
- (3) static water level (feet) 60 below above top of ground.

(4) casing PVC, 168
(material) (depth)
 if telescope see back.
(size)

(5) screen 10", 168
(length) (depth to top)
2", PVC
(size) (material)


(6) pump 1, 8
(HP) (yield gpm)

(type power)

(7) electric log
(yes or no)

(organization running log)

(8) how well bottom plugged

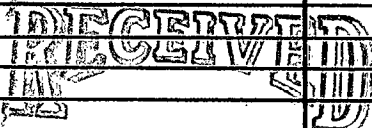

AUG 18 1986


Department of Natural Resources
Bureau of Land & Water Resources

DRILLERS REMARKS:

Sandshark

If well telescopes please
sketch and show depths.

GROUND LEVEL

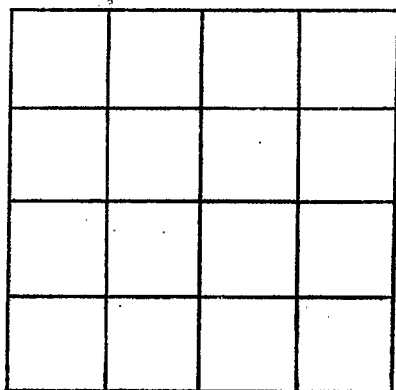

SECTION _____

Please indicate well location X.

ADDITIONAL INFORMATION

If more than one screen,
show locations of each on sketch.