

PEARL RIVER
Pool


MISSISSIPPI DEPARTMENT OF NATURAL RESOURCES
Bureau of Land and Water Resources
Southport Mall
P.O. Box 10631
Jackson, Mississippi 39209
WATER WELL DRILLERS LOG

8-16-86 1986
date well completed

Walker, s Well Drilling
firm name

Pearl River
county well located

LANDOWNER:	description of formations encountered	from	to
R. H. Dudenhefer			
Rt. 1 Carriere Ms.	Red Sand	60	70
<u>7/8</u> (mailing address)	Blue Clay	70	230
	Sand	230	270
WELL LOCATION:			
sec <u>7</u> T <u>4</u> N R <u>19</u> E			
<u>20</u> miles <u>NW</u> of <u>Picayune</u> (distance) (direction) (nearest town)			
WELL PURPOSE: <u>home</u> (home, irrigation, municipal, industrial)			
WELL COMPLETION DATA:			
(1) diameter (inches) <u>2 1/2</u>			
(2) total depth (feet) <u>270</u>			
(3) static water level (feet) <u>60</u> below above top of ground.			
(4) casing <u>PVC</u> <u>260</u> (material) (depth)			
<u> </u> If telescope see back. (size)			
(5) screen <u>15'</u> <u>260</u> (length) (depth to top)			
<u>2 1/2</u> <u>PVC</u> (size) (material)			
(6) pump <u>1</u> <u>8</u> (HP) (yield gpm)			
<u> </u> (type power)			
(7) electric log <u> </u> (yes or no)			
<u> </u> (organization running log)			
(8) how well bottom plugged <u> </u>			
DRILLERS REMARKS:			
<u>Sandshank</u>			

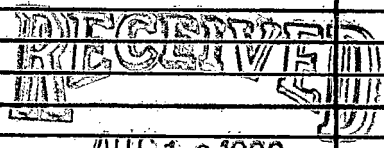


AUG 18 1986

Department of Natural Resources
Bureau of Land and Water Resources

If well telescopes please sketch and show depths.

GROUND LEVEL

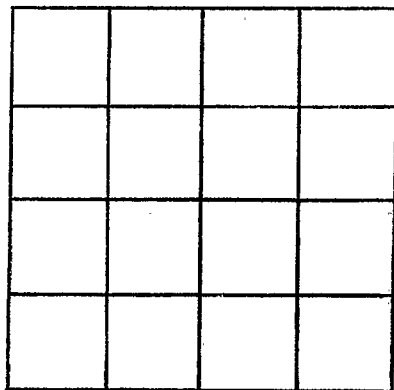

SECTION _____

Please indicate well location X.

ADDITIONAL INFORMATION

If more than one screen,
show locations of each on sketch.