

Pearl River
Pages

MISSISSIPPI DEPARTMENT OF NATURAL RESOURCES
Bureau of Land and Water Resources
Southport Mall
P.O. Box 10631
Jackson, Mississippi 39209
WATER WELL DRILLERS LOG

8-20-86
date well completed

1986

Walker Well Drilling
firm name

Pearl River
county well located

LANDOWNER: Mike Sanders

RT. 1 Carriere, Ms.

(mailing address)

WELL LOCATION:

sec. 7 T 4 N R 12 E
S W

10 miles NW of Picayune
(distance) (direction) (nearest town)

WELL PURPOSE: home
(home, irrigation, municipal, industrial)

WELL COMPLETION DATA:

- (1) diameter (inches) 4"
(2) total depth (feet) 180'
(3) static water level (feet) 70' below above top of ground.

(4) casing Pvc 180'
(material) (depth)

(size) if telescope see back.

(5) screen 15' 180'
(length) (depth to top)

1/2" PVC
(size) (material)

(6) pump 1/2 8
(HP) (yield gpm)

(type power)

(7) electric log (yes or no)


(organization running log)

(8) how well bottom plugged

description of formations encountered

from to

Clay	0	140
Sand	140	180

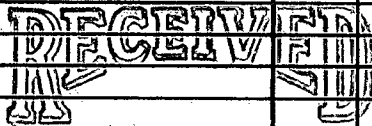

AUG 18 1986


Department of Natural Resources
Bureau of Land & Water Resources

DRILLERS REMARKS:

Sandshark

If well telescopes please sketch and show depths.

GROUND LEVEL

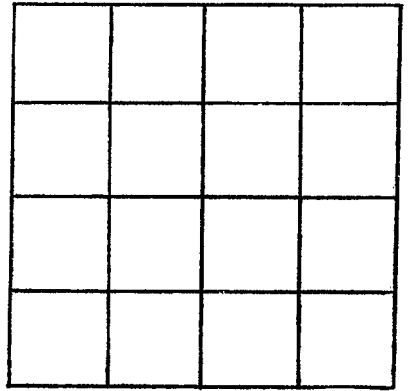

SECTION _____

Please indicate well location X.

ADDITIONAL INFORMATION

If more than one screen,
show locations of each on sketch.