

MISSISSIPPI DEPARTMENT OF NATURAL RESOURCES

Bureau of Land and Water Resources

Southport Mall

P.O. Box 10631

Jackson, Mississippi 39209

WATER WELL DRILLERS LOG

Pearl River
P 2069

8-23-86 19 86
date well completed

Walker Welding
firm name

Pearl River
county well located

LANDOWNER: Paul Raschke
Rt. 1 Box 154 Carriere, Ms.
(mailing address)

description of formations encountered	from	to
Clay	0	50
Sand	50	60
Blue Clay	60	150
Sand	150	188

WELL LOCATION:
sec 2 T 4 N R 17 E
10 miles NW of Picayune
(distance) (direction) (nearest town)

WELL PURPOSE: none
(home, irrigation, municipal, industrial)

WELL COMPLETION DATA:

(1) diameter (inches) 2"

(2) total depth (feet) 188

(3) static water level (feet) 60 below above top of ground.

(4) casing Pvc 188
(material) (depth)
 if telescope see back.
(size)

(5) screen 1/4" 188
(length) (depth to top)
2" PVC
(size) (material)

(6) pump T 8
(HP) (yield gpm)

(type power)

(7) electric log
(yes or no)

(organization running log)

(8) how well bottom plugged


RECEIVED
AUG 16 1986

Department of Natural Resources
Bureau of Land & Water Resources

DRILLERS REMARKS:
Sandshark

If well telescopes please
sketch and show depths.

GROUND LEVEL

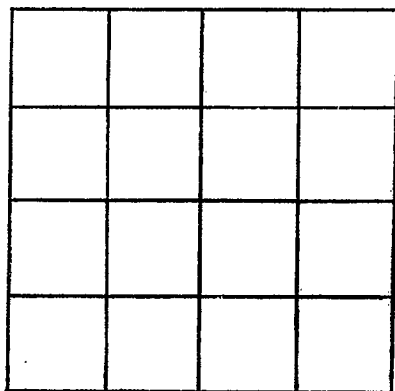

SECTION _____

Please indicate well location X.

ADDITIONAL INFORMATION

If more than one screen,
show locations of each on sketch.