

MISSISSIPPI DEPARTMENT OF NATURAL RESOURCES

Bureau of Land and Water Resources

P.O. Box 10631

Jackson, Mississippi 39209

WATER WELL DRILLERS LOG

COUNTY WELL LOCATED PEARL RIVER	
WELL NUMBER P	CODED
PERMIT NUMBER 0428	
NAME OF DRILLING FIRM WALKER'S WELL DRILLING	
DATE WELL COMPLETED 2072 12-31-86	

NAME & MAILING ADDRESS OF LANDOWNER
Albert Ciuneta
Route 1 Box 555
CARRIERE MISS 39424

WELL LOCATION: SEC **18** TOWNSHIP **4** RANGE **N 17 E**

DISTANCE **17** Miles DIRECTION **SW** of NEAREST TOWN **PEARL RIVER**

OTHER LANDMARK

WELL PURPOSE: Home, Irrigation, Municipal, Industrial, Fish Pond, etc.
HOME

PUMP DATA

PUMP TYPE (Circle One):
Submersible, Turbine, **Jet**, Flowing Well,
Other (Describe)

POWER TYPE (Circle One):
Electric, Tractor, Diesel, Gasoline, Butane,
Other (Describe)

Pump Capacity (GPM) 8	No. of Stages 2	Setting Depth 100 FT.
---------------------------------	---------------------------	---------------------------------

PUMP TEST

Well yielded _____ GPM with a drawdown of _____ ft. after _____ hours of pumping

WELL DATA

Well Depth 205	Casing Diameter (In.) 2"	Casing Length (Ft.) 195
Type of Casing PVC	Hole Depth 205	Depth to Static Water Level 89

TYPE OF COMPLETION: (Circle One or More):
Natural Development, Underreamed, Telescoped, Open Hole, Other

Top of Lap Pipe or Reduction in Casing

FEET IF TELESKOPED OR MORE THAN ONE SCREEN: USE BACK PAGE.

LOG DATA

TYPE OF LOG RUN (Circle One):
No Log Run, Electric, Gamma Ray, Density, Sonic, Neutron, Other (Describe)

Name of Organization Running Log

SCREEN DATA

Diameter - Inches 2"	Length - Feet 10'	Slot Size - Inches #10
Screen Type SLOT	Depth to Bottom - Feet 205	

GEOLOGIC DATA (Office Use Only)

Surface Elev.	Geologic Unit	Unit Thickness	Depth to Top
Subs. SWL	Date	Analysis	Aquifer Test

Driller's Remarks:

RECEIVED


FEB 04 1987

DESCRIPTION OF FORMATIONS ENCOUNTERED	FROM	TO	FORMATIONS (Continued)	FROM	TO
BLUE CLAY	0	175	Department of Natural Resources		
WHITE SAND	175	205	Bureau of Land & Water Resources		

IF MORE SPACE IS NEEDED, USE BACK

If well telescopes please
sketch and show depths.

GROUND LEVEL

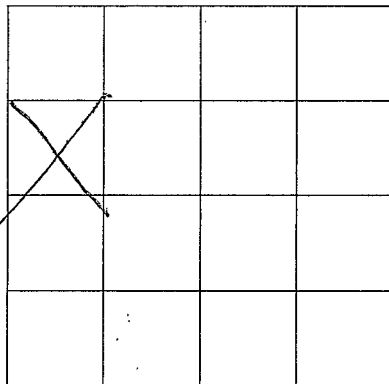

SECTION _____

Please indicate well location X.

ADDITIONAL INFORMATION

If more than one screen,
show location of each on sketch.