

MISSISSIPPI DEPARTMENT OF NATURAL RESOURCES

Bureau of Land and Water Resources

Southport Mall

P.O. Box 10631

Jackson, Mississippi 39209

WATER WELL DRILLERS LOG

Paula Ann
P 2074

19 Aug Penon
date well completed firm name

Penon
county well located

LANDOWNER: Reggie Farmer
R.T. & Carriere
M 39426
(mailing address)

description of formations encountered

from to

White Shell	0	12
White Sand	12	81
Blue Shell	81	155
Blue Sand	155	178

WELL LOCATION:

sec. 5 T 4 N R 17 E
S W
3 miles West of Carriere
(distance) (direction) (nearest town)

WELL PURPOSE: none
(home, irrigation, municipal, industrial)

WELL COMPLETION DATA:

- (1) diameter (inches) 2
- (2) total depth (feet) 178
- (3) static water level (feet) 15 below above top of ground.
- (4) casing PV, 178,
(material) (depth)
(size) if telescope see back.
- (5) screen 5, 173
(length) (depth to top)
1/2, PVC
(size) (material)
- (6) pump no
(HP) (yield gpm)

RECEIVED

JUN 12 1987

Department of Natural Resources
Bureau of Land & Water Resources

(type power)
(7) electric log no
(yes or no)


(organization running log)

(8) how well bottom plugged no
shark

DRILLERS REMARKS:

If well telescopes please sketch and show depths.

GROUND LEVEL

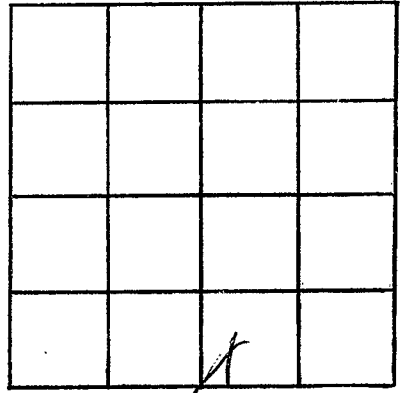

SECTION _____

Please indicate well location X.

ADDITIONAL INFORMATION

If more than one screen, show locations of each on sketch.