

MISSISSIPPI DEPARTMENT OF NATURAL RESOURCES

Bureau of Land and Water Resources

P.O. Box 10631

Jackson, Mississippi 39209

WATER WELL DRILLERS LOG

COUNTY WELL LOCATED PEARL RIVER	
WELL NUMBER P	CODED
2080	
DATE WELL COMPLETED 7-1-88	

PERMIT NUMBER 0-428 LN
NAME OF DRILLING FIRM Walker Well Drilling

NAME & MAILING ADDRESS OF LANDOWNER Kimberly ETHRIDGE			
Rt 1 Box 291 CARLIERE			
MS.			
WELL LOCATION: SEC	TOWNSHIP	RANGE	
18	4	N	17
DISTANCE		DIRECTION	NEAREST TOWN
10 Miles		N	PRAYUNE
OTHER LANDMARK			
WELL PURPOSE: Home, Irrigation, Municipal, Industrial, Fish Pond, etc. HOME			

PUMP DATA		
PUMP TYPE (Circle One): <input checked="" type="radio"/> Submersible, <input type="radio"/> Turbine, <input type="radio"/> Jet <input type="radio"/> Flowing Well, Other (Describe) _____		
POWER TYPE (Circle One): Electric, <input type="radio"/> Tractor, <input type="radio"/> Diesel, <input type="radio"/> Gasoline, <input type="radio"/> Butane, Other (Describe) _____		
Pump Capacity (GPM)	No. of Stages	Setting Depth
		FT.
PUMP TEST		
Well yielded _____ GPM with a drawdown of _____ ft. after _____ hours of pumping		

WELL DATA		
Well Depth 170'	Casing Diameter (In.) 4"	Casing Length (Ft.) 150'
Type of Casing PVC	Hole Depth 170	Depth to Static Water Level 10'
TYPE OF COMPLETION: (Circle One or More): <input checked="" type="radio"/> Gravel Packed, <input type="radio"/> Underreamed, <input type="radio"/> Telescoped, <input checked="" type="radio"/> Natural Development, <input type="radio"/> Open Hole, <input type="radio"/> Other (Describe) AIR		
Top of Lap Pipe or Reduction in Casing		
FEET	IF TELESCOPED OR MORE THAN ONE SCREEN: USE BACK PAGE	

LOG DATA	
TYPE OF LOG RUN (Circle One): <input type="radio"/> No Log Run, <input type="radio"/> Electric, <input type="radio"/> Gamma Ray, <input type="radio"/> Density, <input type="radio"/> Sonic, <input type="radio"/> Neutron, Other (Describe) _____	
Name of Organization Running Log	

SCREEN DATA		
Diameter - Inches 4"	Length - Feet 10'	Slot Size - Inches #8
Screen Type SLOT	Depth to Bottom - Feet 170	


GEOLOGIC DATA (Office Use Only)			
Surface Elev.	Geologic Unit	Unit Thickness	Depth to Top
Subs. SWL	Date	Analysis	Aquifer Test
Driller's Remarks			

DESCRIPTION OF FORMATIONS ENCOUNTERED	FROM	TO	FORMATIONS (Continued)	FROM	TO
BLACK DIRT	0	10	<div style="font-size: 2em; font-weight: bold; opacity: 0.5;">RECEIVED</div> <div style="font-size: 1.5em; font-weight: bold; margin-top: 10px;">AUG 22 1988</div> <div style="font-size: 0.8em; margin-top: 20px;"> Department of Natural Resources Bureau of Land & Water Resources </div>		
SAND	10	20			
BLUE CLAY	20	50			
WHITE CLAY	50	80			
SAND	80	170			

IF MORE SPACE IS NEEDED, USE BACK

If well telescopes please
sketch and show depths.

GROUND LEVEL

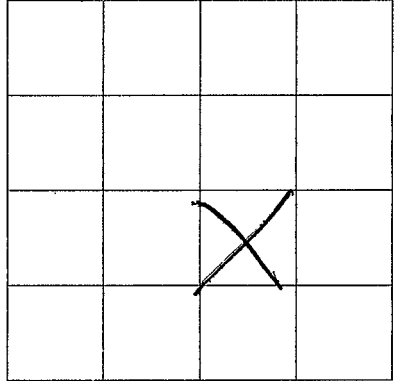

SECTION _____

Please indicate well location X.

ADDITIONAL INFORMATION

If more than one screen,
show location of each on sketch.